


9-15-08

N
↑

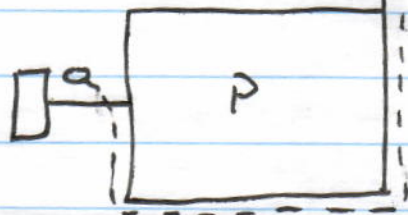

0- - 1

61D. 109

Fall Creek Regional Waste District
P.O. Box 59
Pendleton, IN 46064-0059
765-778-7544 WWW.FCRWD.COM

Date: 06/26/08 Time: 12:48
CREDIT CARD SALE


Card Data: [REDACTED]
Tran Amount: 570.00
Approval Code: 046374
Clerk ID: BECCA
Invoice #: tap fee
Card Balance: 0.00
Record #: 005
Name: Benjamin Nagengast
AVS Response: Street and Zip(5) match
CVV2 Response: Match

x Receipt # 9304

CARDHOLDER SIGNATURE

I agree to pay the above total amount
according to the card issuer agreement.

Merchant Copy

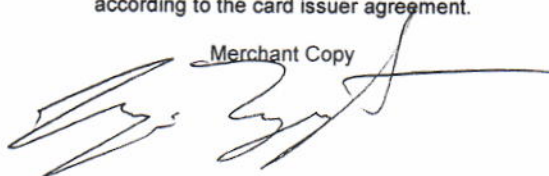

Fall Creek Regional Waste District
P.O. Box 59
Pendleton, IN 46064-0059
765-778-7544 WWW.FCRWD.COM

Date: 08/11/08 Time: 14:29
CREDIT CARD SALE

Card Data: [REDACTED]
Tran Amount: 1391.00
Approval Code: 073914
Clerk ID: BECCA
Invoice #: grinder
Card Balance: 0.00
Record #: 030
Name: Ben Nagengast
AVS Response: Zip(5) match only
CVV2 Response: Match

COPY

X Ben Nagengast
CARDHOLDER SIGNATURE

I agree to pay the above total amount
according to the card issuer agreement.

Merchant Copy

Receipt #: 9333