



FALL CREEK REGIONAL WASTE DISTRICT

Box 44, Pendleton, Indiana 46064

1-0000381.00

No 000251

APPLICATION FOR SEWER PERMIT

Permit No. _____ Date 10-7-85
Permit Void 90 days from Date of Issuance
Owner Name Jack Brunner
Property Address 521 Sixth St
Lot # _____ P.O. Box 212
Town Ingalls, IN Zip Code 46048
Phone 485-5847 Water Meter no
\$ 150.00 Tap on Fee Paid
\$ 25.00 Inspection fee paid

Application is hereby made for connection to the Fall Creek Regional Waste District Sewer System for the above listed property - Permit Type: Residential [checked], Commercial _____, Industrial _____, or Governmental/Institutional _____.

All workmanship and materials shall conform to the standards of the District Ordinance as described in Ordinance 84-2 and 84-3 as amended. Acceptance and approval must be made by the District inspector or his duly authorized representative before backfilling and final connection is made to the main sewer lines.

The Fall Creek Regional Waste District is responsible for the inspection, approval of materials, and installation techniques only. All costs for materials and installation and any liabilities resulting from same is the sole responsibility of the property owner.

I have read and fully understand the above provisions and agree to comply by said provisions.


Jack Brunner
APPLICANT(S) SIGNATURE

INSPECTOR [Signature]

Date inspected 10/8/85 Approved [checked] Rejected _____
Reason for rejection _____

Date reinspected _____ Approved _____ Rejected _____

Notes:
Size Pipe 6"
Type Pipe F.V.C.
Basement Yes No [checked]
Sump Pump Yes No [checked]
Downspout to Ground Yes No [checked]
Septic Tank Pumped & filled Yes No
Contractor Sam Flatford
Special Conditions _____

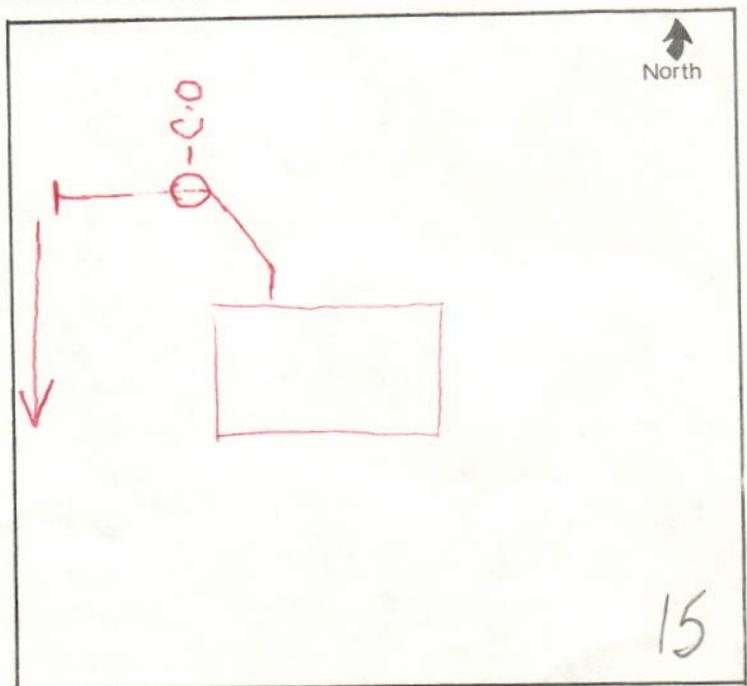

North

15