

add order
on file



FALL CREEK REGIONAL WASTE DISTRICT

9378 S. 650 West PO Box 59
Pendleton, IN 46064-0059 778-7544

21-02277.00

APPLICATION FOR SEWER PERMIT

Nº 2883

Date 9-13-00

Permit Void 90 days from Date of Issuance

Owner Name STEVE VENDER

Property Address 521 N. ALFONTE

Lot # _____ P.O. Box _____

Town INGALLS, IN Zip Code 46048

Phone 485-4441 City Water X Well _____

\$ 2485.00 Tap on Fee Paid

\$ _____ ~~Inspection fee paid~~

Application is hereby made for connection to the Fall Creek Regional Waste District Sewer System for the above listed property - Permit Type: Residential X, Commercial _____, Industrial _____, or Governmental/Institutional _____. User Information _____.

All workmanship and materials shall conform to the standards of the District Ordinance as described in Ordinance 84-2 and 84-3 as amended. Acceptance and approval must be made by the District inspector or his duly authorized representative before backfilling and final connection is made to the main sewer lines. Any violation of applicable regulations will cause all lines and appurtenances in violation to be removed and replaced at the owners expense.

The Fall Creek Regional Waste District is responsible for the inspection, approval of materials, and installation techniques only. All costs for materials and installation and any liabilities resulting from same is the sole responsibility of the property owner.

I have read and fully understand the above provisions and agree to comply by said provisions.

Steve Vender
APPLICANT(S) SIGNATURE


INSPECTOR T

Date inspected 10-10-2000 Approved X Rejected _____

Reason for rejection _____

Date reinspected _____ Approved _____ Rejected _____

Notes:
Size Pipe 6"
Type Pipe SDR 35
Basement Yes _____ No X
Sump Pump Yes _____ No X
Downspout to Ground Yes X No _____
Septic Tank Pumped & filled Yes _____ No _____
Contractor BL Brown
Special Conditions _____
Existing Home _____
New Construction X

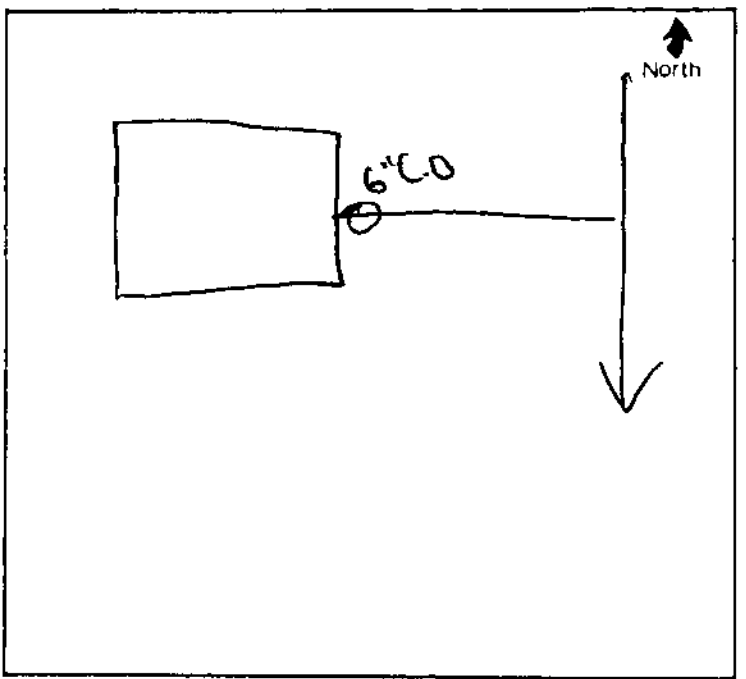

VENDEL-WILSON VENTURES

600 E. BROADWAY
FORTVILLE, IN 46040-1546

3226

Date 9-13-00

71-367749
06

Pay to the
Order of

F. C. R. W. D.

\$ 4970⁰⁰/₁₀₀

FOUR THOUSAND NINE HUNDRED SEVENTY⁰⁰/₁₀₀

Dollars



© 2000 American

[Signature]

FORTVILLE BANKING COMPANY
FORTVILLE, IN 46040

For

[Signature]

⑆074903670⑆

3226

MARCOON SHEFFIELD