

Gidw.


PROJECT Phase II SHEET _____ OF _____

SUBJECT _____ DATE 4-5-18

JOB NO. 4447

BY ALIAS

Apartment At 522 Taylor

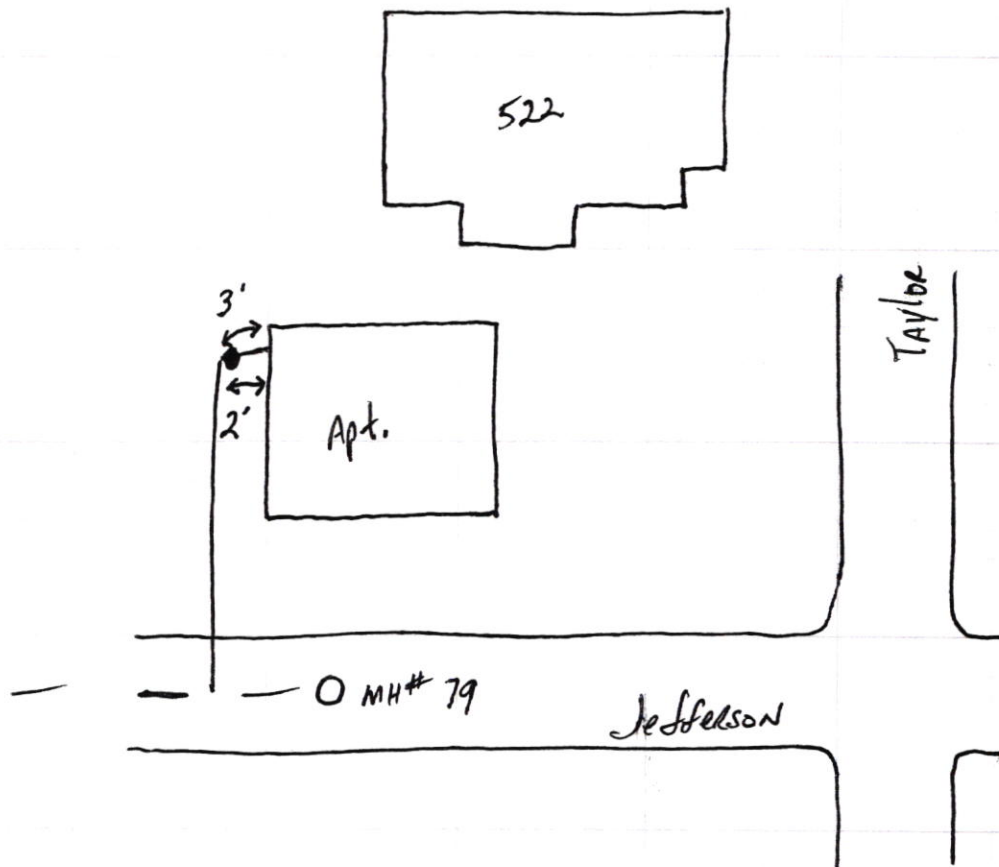

522 Taylor - APT

SRP
Phase II

4.11.18

