

Gidw.

PROJECT

Phase II

SHEET

OF

SUBJECT

DATE

6-25-18

JOB NO.


4447

BY

Atlas

524 S. Center

N →

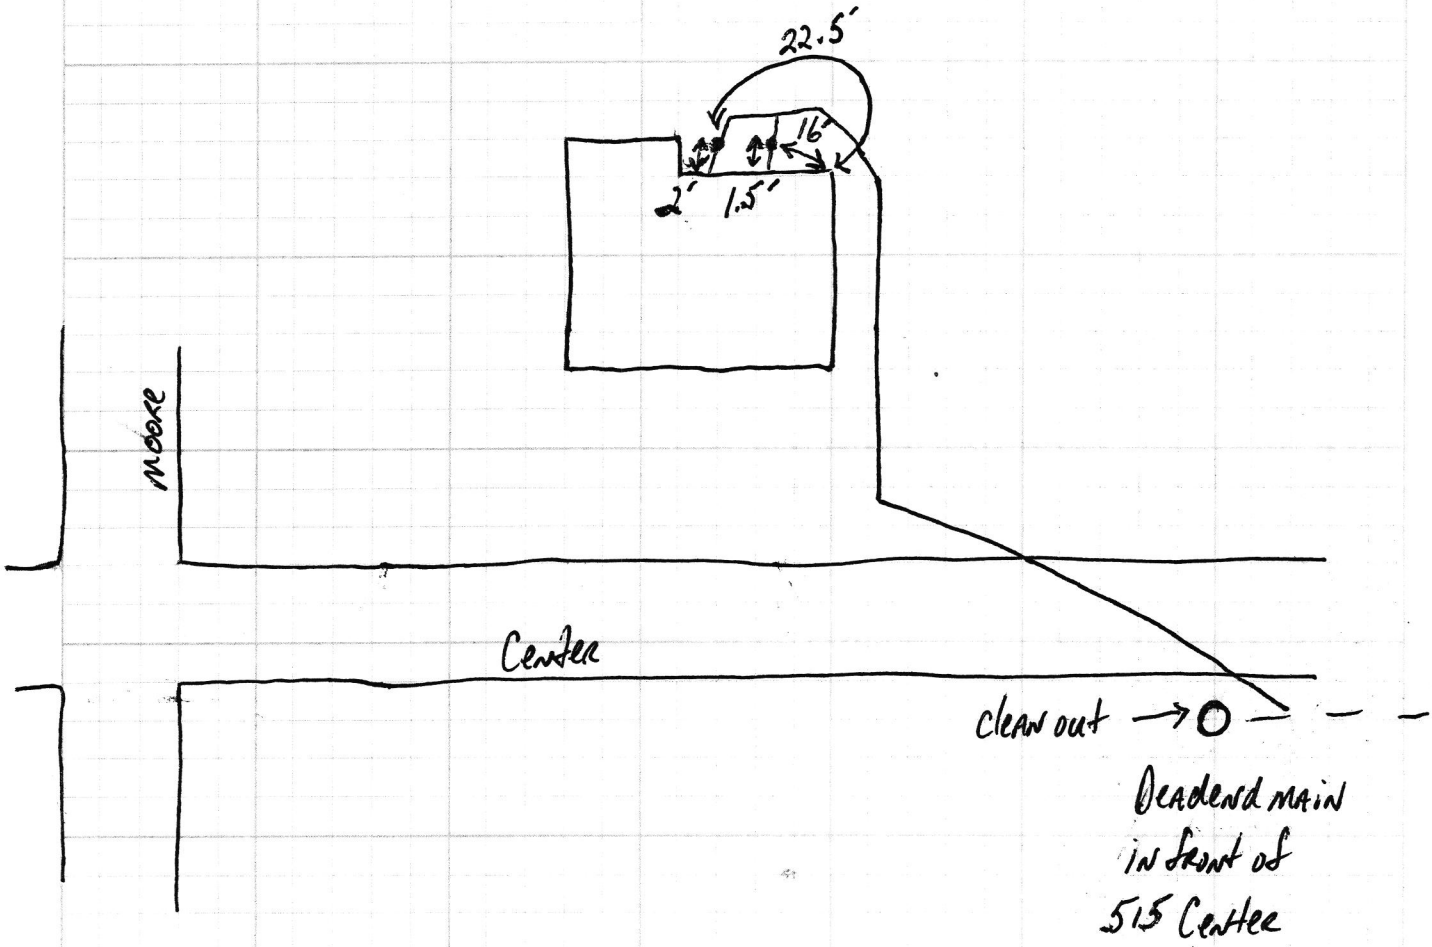

S&H Center

S&H Phase II

7.6.18

