

Gidw.


PROJECT Phase II SHEET _____ OF _____

SUBJECT _____ DATE 4-17-18

JOB NO. 4447

BY Atlas

525 S. Broadway

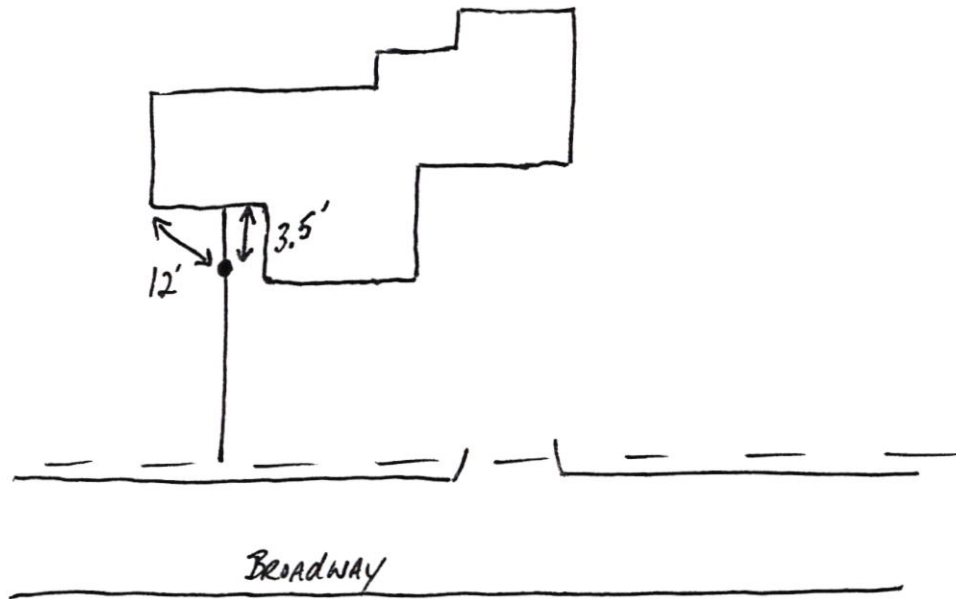

525 S Broadway

SRF
Phase II

4.20.18

