

add order
on file



FALL CREEK REGIONAL WASTE DISTRICT

9378 S. 650 West PO Box 59
Pendleton, IN 46064-0059 778-7544 22-23330.00

APPLICATION FOR SEWER PERMIT

Nº 2084

Date 5-16-94

Permit Void 90 days from Date of Issuance

Owner Name Richard Metzger

Property Address 526 E U.S. 36

Lot # _____ P.O. Box _____

Town PENDLETON, IN Zip Code 46064

Phone _____ City Water _____ Well ☒

\$ 700.00 Tap on Fee Paid

\$ 25.00 Inspection fee paid

Application is hereby made for connection to the Fall Creek Regional Waste District Sewer System for the above listed property - Permit Type: Residential ☒, Commercial _____, Industrial _____, or Governmental/Institutional _____. User Information _____.

All workmanship and materials shall conform to the standards of the District Ordinance as described in Ordinance 84-2 and 84-3 as amended. Acceptance and approval must be made by the District inspector or his duly authorized representative before backfilling and final connection is made to the main sewer lines. Any violation of applicable regulations will cause all lines and appurtenances in violation to be removed and replaced at the owners expense.

The Fall Creek Regional Waste District is responsible for the inspection, approval of materials, and installation techniques only. All costs for materials and installation and any liabilities resulting from same is the sole responsibility of the property owner.

I have read and fully understand the above provisions and agree to comply by said provisions.


Richard V. Metzger
APPLICANT(S) SIGNATURE

INSPECTOR TJM
Date inspected 7/27/94 Approved ☒ Rejected _____

Reason for rejection _____

Date reinspected _____ Approved _____ Rejected _____

Notes:
Size Pipe 1 1/4 LATERAL
Type Pipe 100 PSI
Basement Yes _____ No ☒
Sump Pump Yes _____ No ☒
Downspout to Ground Yes ☒ No _____
Septic Tank Pumped & filled Yes _____ No _____
Contractor Earl Davis
Special Conditions _____
Existing Home _____
New Construction ☒

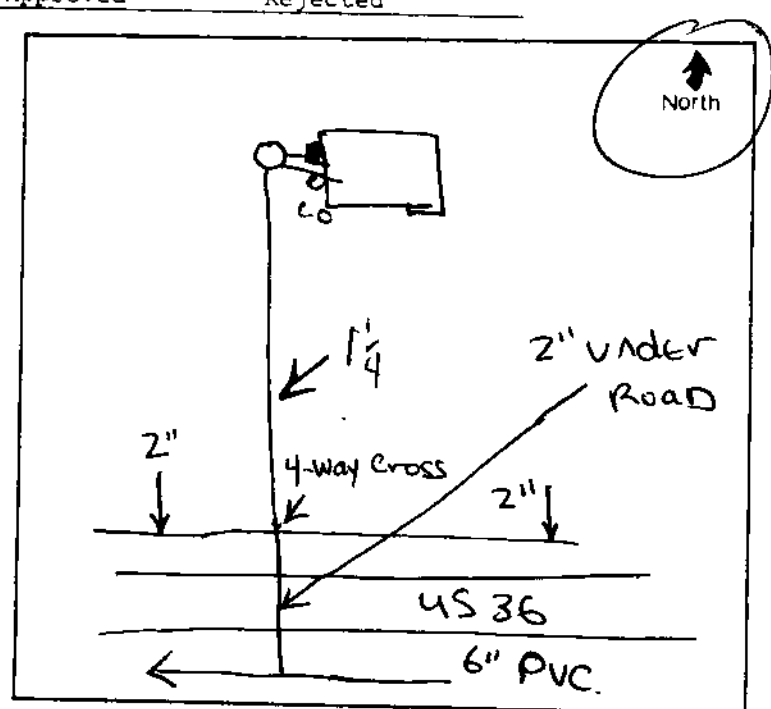



Madison County
Government Center
16 East 9th Street, Room 313
Anderson, IN 46016
(317) 641-9523

Richard H. Shafer, M.D.
Health Officer

Stephen L. Ford, R.E.H.S.
Administrator

SATELLITE OFFICES:

Shalico Center
1106 Meridian Plaza
Suite 640
Anderson, IN 46016
646-9206

W.I.C.
23rd and Jefferson
Anderson, IN 46016
646-9272

March 15, 1994

Richard Metzger
8806 Surrey Dr.
Pendleton, IN 46064

Dear Mr. Metzger:

Please be advised that Fall Creek Regional Waste District has notified our office that sanitary sewer is available for property on the north side of State Road 36, east of County Road 25E. Therefore, in accordance with the Madison County Sewage Disposal Ordinance, a permit for on-site sewage disposal shall not be issued by this office and you shall be required to connect to the sanitary sewer as provided by Fall Creek Regional Waste District.

If you have any questions, please contact me at 641-9536 or Joe Rowlett, Fall Creek Regional Waste District Manager, at 778-7544.

Sincerely,

Thomas A. Carr, Jr.

Thomas A. Carr
Environmental Supervisor

Madison County Health Department
County Government Center
641-9523 16 E. 9th St.
Anderson 46016

APPLICATION FOR SEWAGE DISPOSAL PERMIT

APPLICANTS NAME RICHARD METZING
ADDRESS 8806 SURREY DR. PEDDLETOWN, KY
TELEPHONE NUMBER 778-7353
PROPERTY OWNER RICHARD METZING
Complete and accurate instructions for getting to site On St. Rd 36
900' East of Co. Road 25 East on North
side of Road

OFFICE ONLY

Tank Size _____
Laterals _____
Trench Depth _____
Soil Type _____
Soil Limitations _____
Date _____
Sanitarian _____

Has this property been zoned by the Planning Commission? _____

Type of Dwelling: ☒ House ☐ Mobile Home ☐ Multiple Dwelling No. of Bedrooms 3

In the space below draw the property lines and location of the building, well, driveway, patios, swimming pool, easements, trees, drainage tiles, or any other limiting factors. Proposed home location should be marked at site prior to investigation by this department. DO NOT DRAW IN THE SEPTIC SYSTEM.

Minimum separations: 50 ft. from well, 10 ft. from house, 5 ft. from property lines, driveways, outbuildings, etc.
10 ft. between trenches (center to center) and 10 ft. from perimeter drainage.

DRAW TO SCALE

NORTH

11.6 Acres

Co. Rd 25 East

107'

230' to Center Rd 36

ST. ROAD 36 900'

FCRWD 3-9-94 DATE

Applicant Required To Hook-Up To FCRWD Systems At this Time

YES ☒ NO ☐

Approved J. J. Rowlett General Mgr.

Signature Richard Metzger Date 3-1-94

Contractor or Installer's Name _____

The design and location of the sewage disposal system will be designated by the Health Department. Failure to comply with this may cause the installation to be rejected. The Health Department must be contacted for final inspection of this installation at least 48 hours prior to the final inspection.

concrete
noting
~~Tracy~~

AS-30127

WO# 9444

