

Gidw.


PROJECT Phase II SHEET _____ OF _____

SUBJECT _____ DATE 4-30-18

JOB NO. 4447

BY Atlas

528 S. Broadway

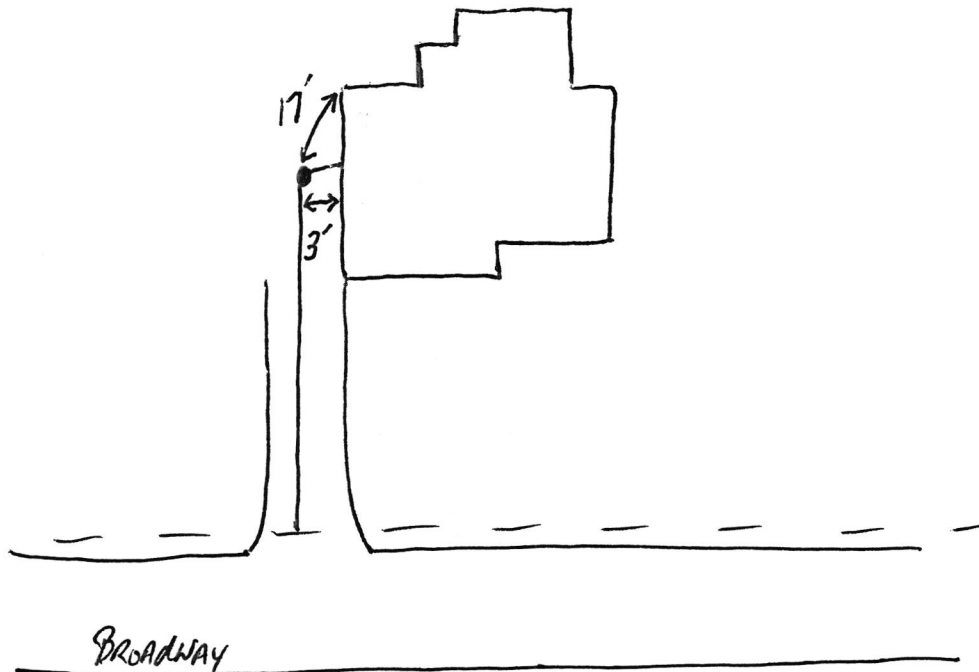

528 S Broadway

SRF
Phase II

5-3-18

