

Gidw.

PROJECT Phase II SHEET _____ OF _____


SUBJECT _____ DATE 5-31-18

JOB NO. 4447

BY Atlas

52.9 S. MAIN

← N

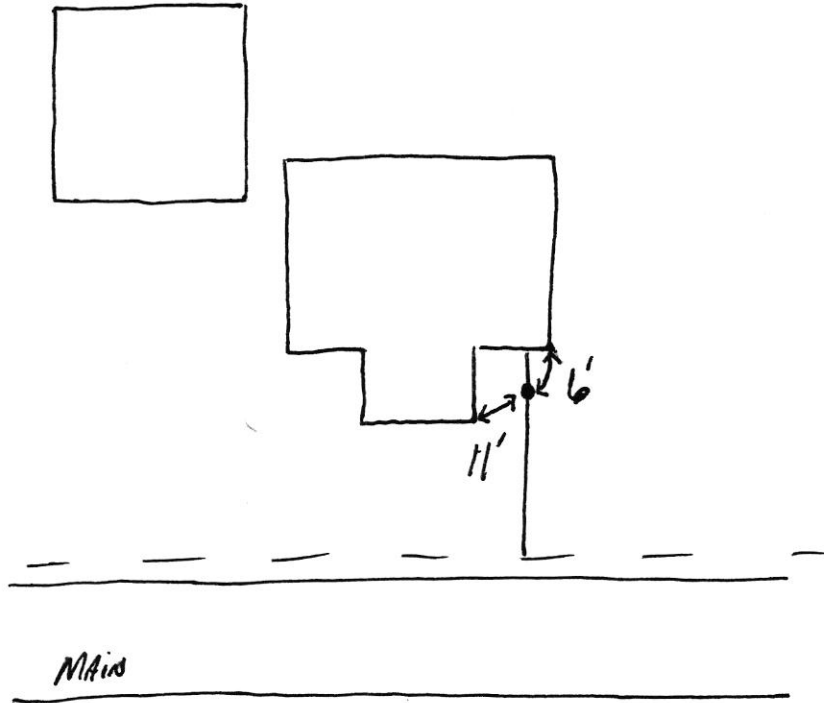

Sa9 8 main

SRF Phase III

6.2.18

