


Gidw.

PROJECT Phase II SHEET _____ OF _____
SUBJECT _____ DATE 3-5-18
JOB NO. 4447
BY Atlas

530 S. Pendleton

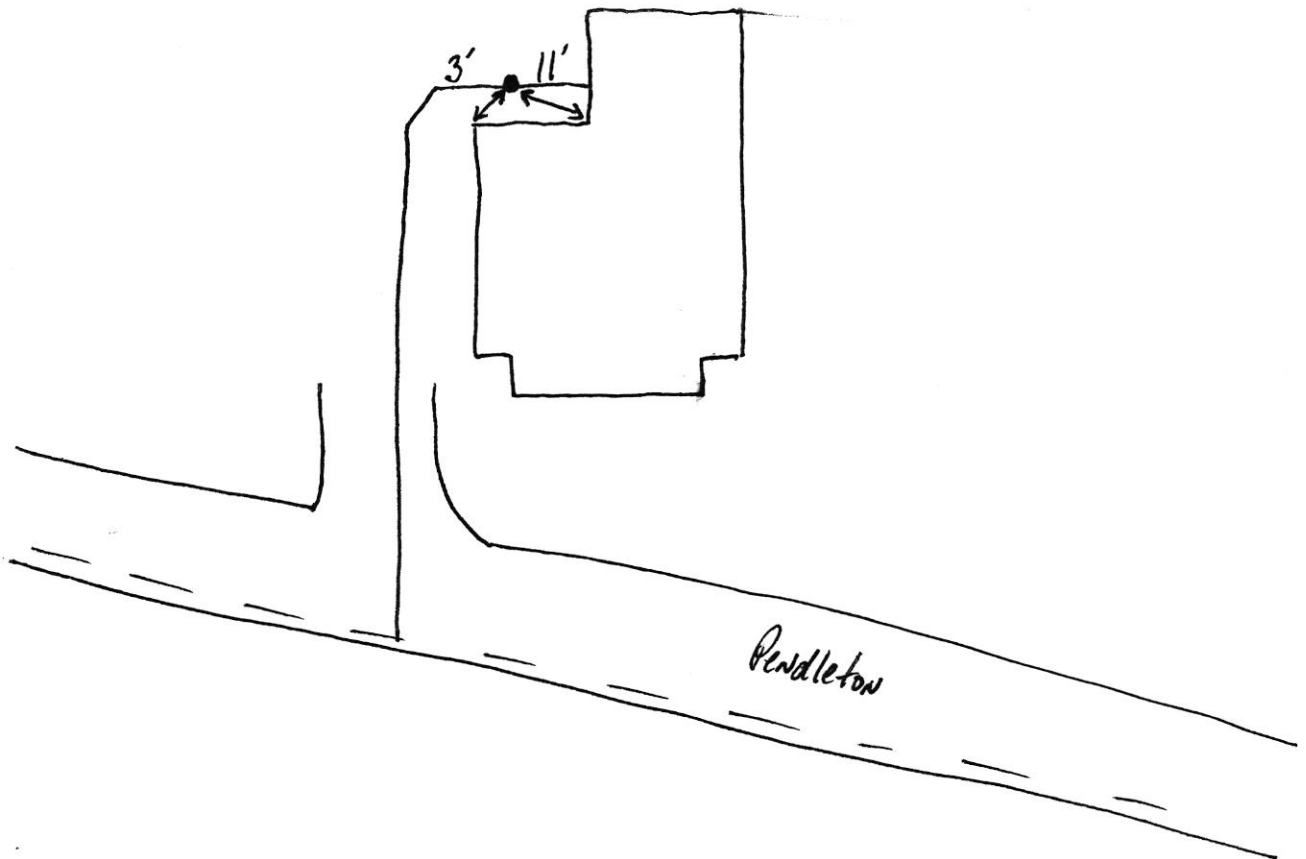

530 S Penelliston

SRP Phase II

