


Gidw.

PROJECT Phase II SHEET _____ OF _____
SUBJECT _____ DATE 4-30-18
JOB NO. 4447
BY Atlas

532 S. Broadway

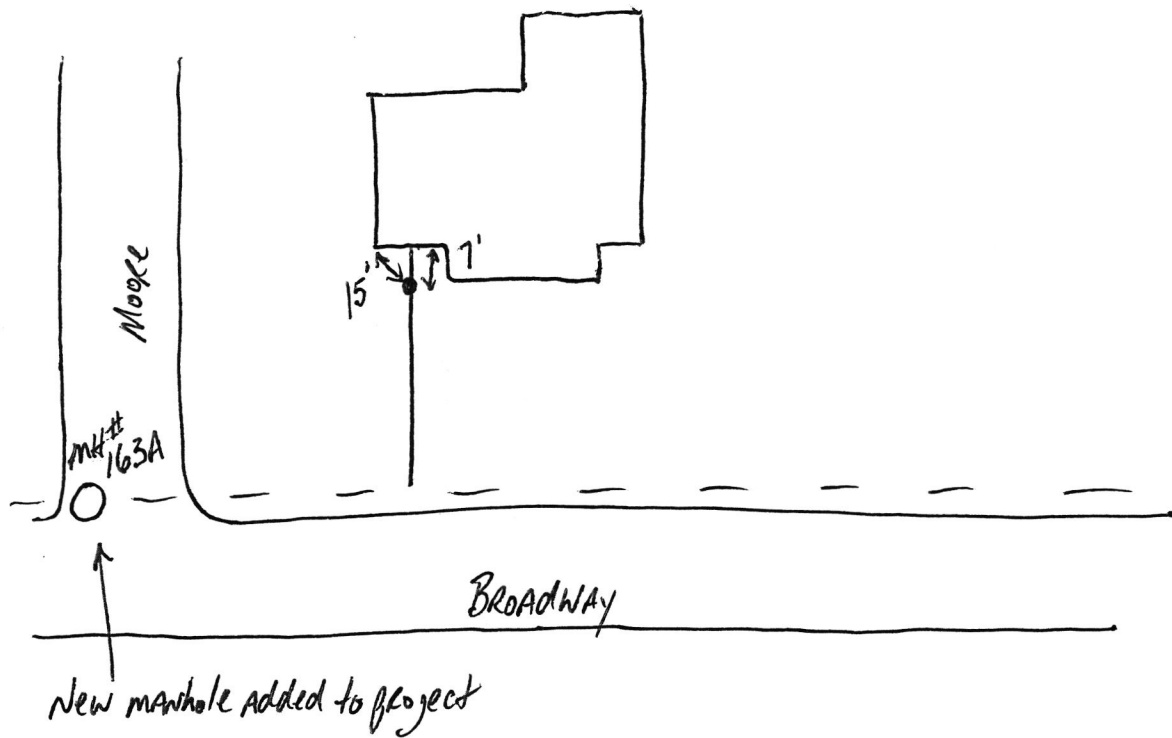

532 S Broadway

SRF
Phase II

5-3-18

