



FALL CREEK REGIONAL WASTE DISTRICT

9378 S. 650 West PO Box 59
Pendleton, IN 46064-0059 778-7544

APPLICATION FOR SEWER PERMIT

Nº 2886

Date 9-14-00

Permit Void 90 days from Date of Issuance

Owner Name Barbara Phillips

Property Address 5339 S 100 W

Lot # _____

P.O. Box _____

Town Anderson

IN Zip Code 46013

Phone _____

City Water _____

Well ☒

\$ N/A Tap on Fee Paid

\$ N/A Inspection fee paid

grinder unit paid for by Long & Koffler

Application is hereby made for connection to the Fall Creek Regional Waste District Sewer System for the above listed property - Permit Type: Residential ☒, Commercial _____, Industrial _____, or Governmental/Institutional _____. User Information _____.

All workmanship and materials shall conform to the standards of the District Ordinance as described in Ordinance 84-2 and 84-3 as amended. Acceptance and approval must be made by the District inspector or his duly authorized representative before backfilling and final connection is made to the main sewer lines. Any violation of applicable regulations will cause all lines and appurtenances in violation to be removed and replaced at the owners expense.

The Fall Creek Regional Waste District is responsible for the inspection, approval of materials, and installation techniques only. All costs for materials and installation and any liabilities resulting from same is the sole responsibility of the property owner.

I have read and fully understand the above provisions and agree to comply by said provisions.

APPLICANT(S) SIGNATURE

INSPECTOR B

Date inspected 9-29-00

Approved ☒

Rejected _____

Reason for rejection _____

Date reinspected _____

Approved _____

Rejected _____

Notes:

Size Pipe 6 "

Type Pipe PVC

Basement Yes _____ No ☒

Sump Pump Yes _____ No ☒

Downspout to Ground Yes ☒ No _____


Septic Tank Pumped & filled Yes ☒ No _____

Contractor Long & Koffler

Special Conditions _____

Existing Home ☒

New Construction _____

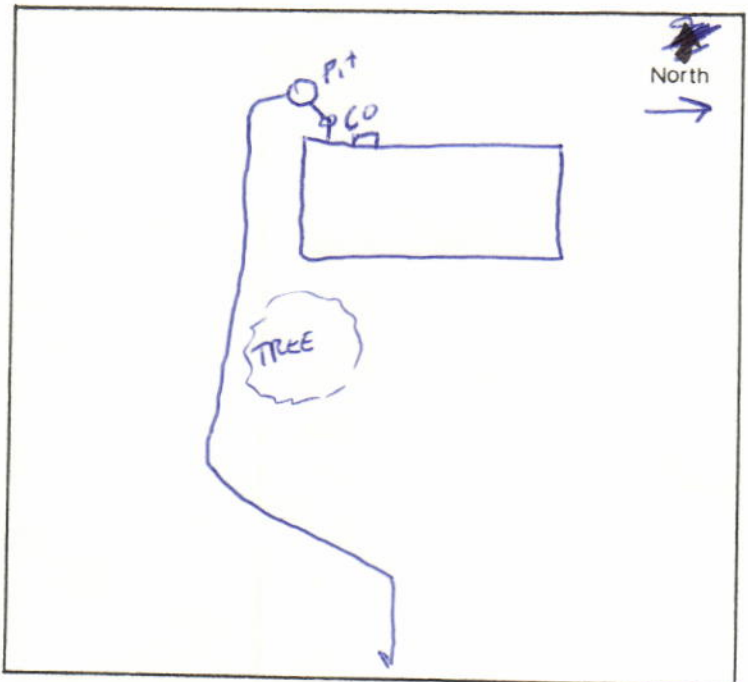

LONG & KOFFER, INC.
1795 W. HUNTSVILLE RD.
RENDLETON, INDIANA 46064
765/778-5219

NATIONAL CITY BANK
INDIANAPOLIS, INDIANA 46255
20-6/740

9/14/2000

PAY TO THE
ORDER OF

Fall Creek Regional Waste District

\$2,049.60

Two-Thousand Forty-Nine Dollars and

60/100

DOLLARS

MEMO:

[Signature]

⑈001191⑈ ⑆074000065⑆

SECURITY FEATURES: MICRO PRINT TOP & BOTTOM BORDERS - COLORED PATTERN - OPTICAL WATERMARK ON REVERSE SIDE - IMITATION FEATURE INDICATES A COPY

*grinder
pump
for Dante & Barbara*