

add order
on file



FALL CREEK REGIONAL WASTE DISTRICT

9378 S. 650 West PO Box 59
Pendleton, IN 46064-0059 778-7544 21-00630.00

APPLICATION FOR SEWER PERMIT

Nº 2486

Date 10/23/97

Permit Void 90 days from Date of Issuance

Owner Name Cindy Ripberger

Property Address 533 Manifold Street

Lot # _____ P.O. Box _____

Town Ingalls, IN Zip Code _____

Phone _____ City Water ☒ Well _____

\$ 2885.00 Tap on Fee Paid

\$ _____ Inspection fee paid

Application is hereby made for connection to the Fall Creek Regional Waste District Sewer System for the above listed property - Permit Type: Residential ☒, Commercial _____, Industrial _____, or Governmental/Institutional _____. User Information _____.

All workmanship and materials shall conform to the standards of the District Ordinance as described in Ordinance 84-2 and 84-3 as amended. Acceptance and approval must be made by the District inspector or his duly authorized representative before backfilling and final connection is made to the main sewer lines. Any violation of applicable regulations will cause all lines and appurtenances in violation to be removed and replaced at the owners expense.

The Fall Creek Regional Waste District is responsible for the inspection, approval of materials, and installation techniques only. All costs for materials and installation and any liabilities resulting from same is the sole responsibility of the property owner.

I have read and fully understand the above provisions and agree to comply by said provisions.

Valm E. ... for Dan Wilbur House
APPLICANT(S) SIGNATURE

INSPECTOR B

Date inspected 11-6-97 Approved ☒ Rejected _____

Reason for rejection _____

Date reinspected _____ Approved _____ Rejected _____

Notes:

Size Pipe 6 "

Type Pipe PVC

Basement Yes _____ No ☒

Sump Pump Yes _____ No ☒

Downspout to Ground Yes ☒ No _____


Septic Tank Pumped & filled Yes _____ No ☒

Contractor Stowers Excavating

Special Conditions _____

Existing Home _____

New Construction ☒

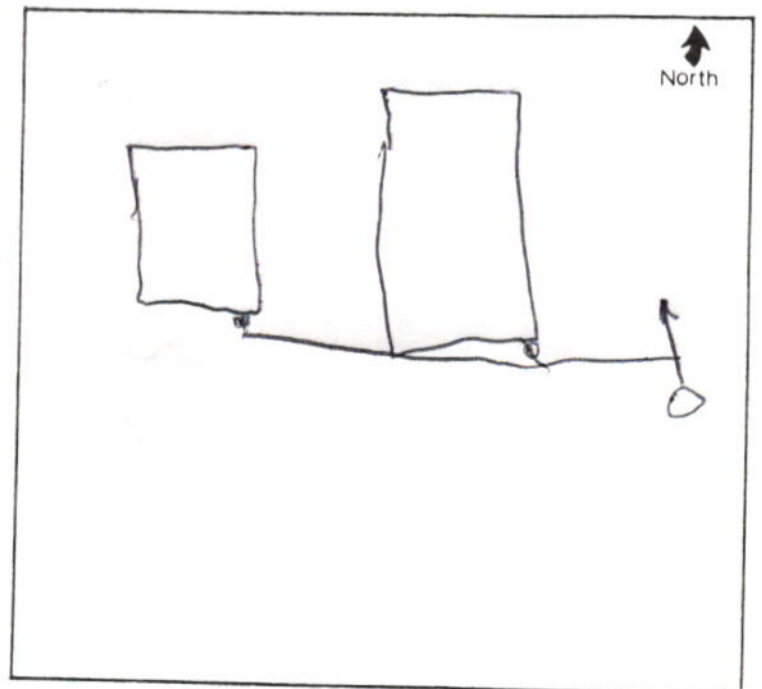

047140

DON WELTON MANUFACTURED HOUSING, INC.

6634 E. NOO S.
MARION, IN 46953

STAR FINANCIAL BANK

MARION, IN 46953

71-1046/749

00047140

**** TWO THOUSAND EIGHT HUNDRED EIGHTY FIVE & 00/100 DOLLARS

DATE

AMOUNT

PAY
TO THE
ORDER
OF:

10/22/97 *****\$2,885.00

FALL CREEK REGIONAL WASTE

MP

⑈047140⑈ ⑈

⑈