

*Gidw.*

PROJECT

*Phase*

SHEET

OF

SUBJECT

DATE

*6-6-18*

JOB NO.


*4447*

BY

*Atlas*

*533 S. Pendleton*

← *N*

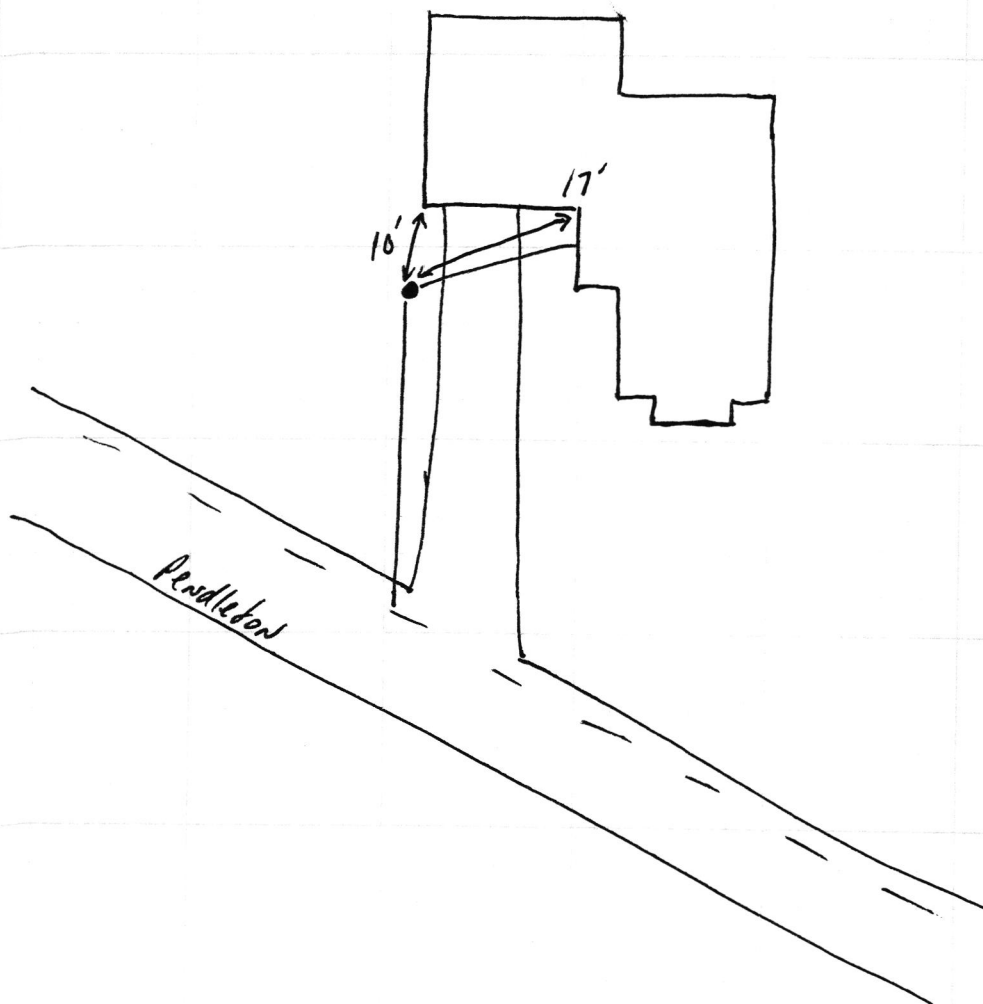

533 S Pendleton

SF Phase II

6.11.18

