

Gidw.


PROJECT Phase II SHEET \_\_\_\_\_ OF \_\_\_\_\_

SUBJECT \_\_\_\_\_ DATE 4-18

JOB NO. 4447

BY Atlas

535 S. Broadway

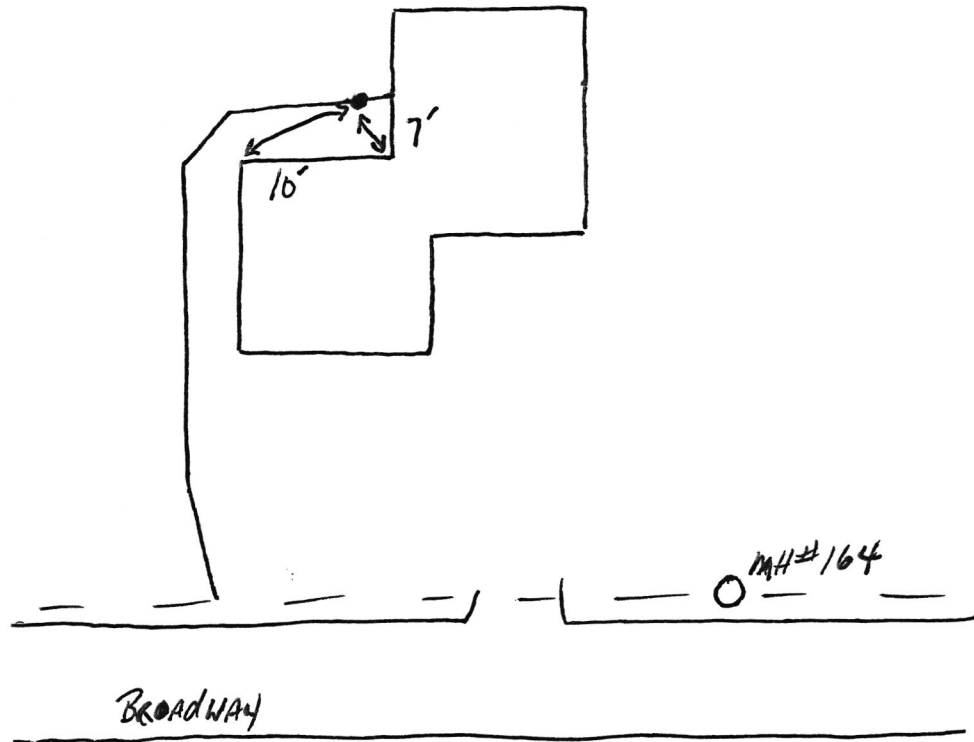

535 S Broadway

SRF  
Phase II

5.3.18

