

Gidw.

PROJECT Phase II SHEET _____ OF _____


SUBJECT _____ DATE 5-31-18

JOB NO. 4447

BY Atlas

535 S. Main

← N

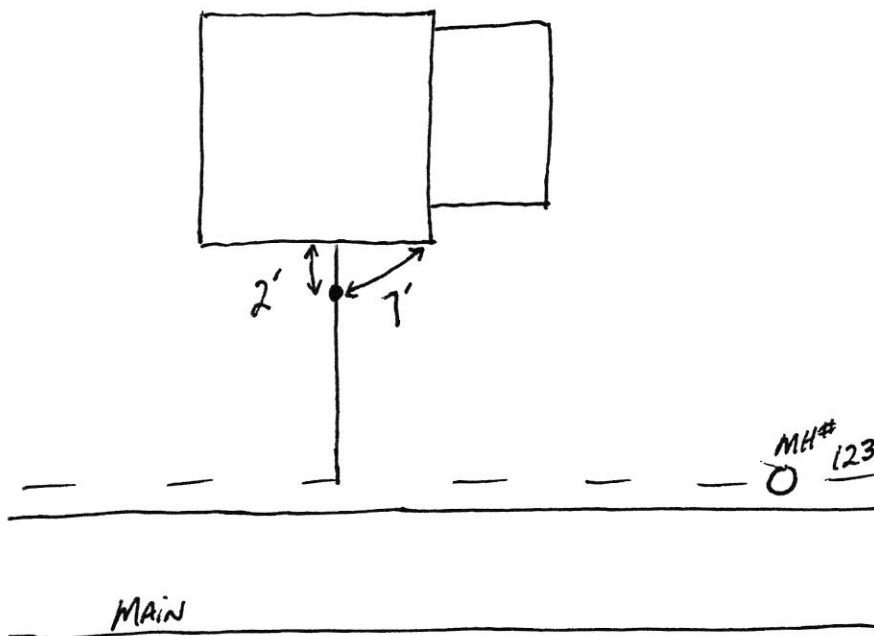

535 S Main

SRF Phase II

6-2-18

