



FALL CREEK REGIONAL WASTE DISTRICT

 9378 S. 650 West PO Box 59
 Pendleton, IN 46064-0059 778-7544

APPLICATION FOR SEWER PERMIT

No 2885

Date 9-14-00

Permit Void 90 days from Date of Issuance

Owner Name Dante PhillipsProperty Address 5363 S 100 W

Lot # _____ P.O. Box _____

Town Anderson, IN Zip Code 46013Phone _____ City Water _____ Well ☒10/4/00 \$ 400 Tap on Fee Paid

\$ _____ Inspection fee paid

grinder unit paid for
by Long + Koffer

Application is hereby made for connection to the Fall Creek Regional Waste District Sewer System for the above listed property - Permit Type: Residential ☒, Commercial _____, Industrial _____, or Governmental/Institutional _____. User Information _____.

All workmanship and materials shall conform to the standards of the District Ordinance as described in Ordinance 84-2 and 84-3 as amended. Acceptance and approval must be made by the District inspector or his duly authorized representative before backfilling and final connection is made to the main sewer lines. Any violation of applicable regulations will cause all lines and appurtenances in violation to be removed and replaced at the owners expense.

The Fall Creek Regional Waste District is responsible for the inspection, approval of materials, and installation techniques only. All costs for materials and installation and any liabilities resulting from same is the sole responsibility of the property owner.

I have read and fully understand the above provisions and agree to comply by said provisions.

APPLICANT(S) SIGNATURE _____

INSPECTOR BenDate inspected 10-2-00 Approved ☒ Rejected _____


Reason for rejection _____

Date reinspected _____ Approved _____ Rejected _____

Notes:

Size Pipe 4" "Type Pipe PVC 35Basement Yes _____ No ☒Sump Pump Yes _____ No ☒Downspout to Ground Yes ☒ No _____Septic Tank Pumped & filled Yes ☒ No _____Contractor KofferSpecial Conditions FisherExisting Home ☒

New Construction _____

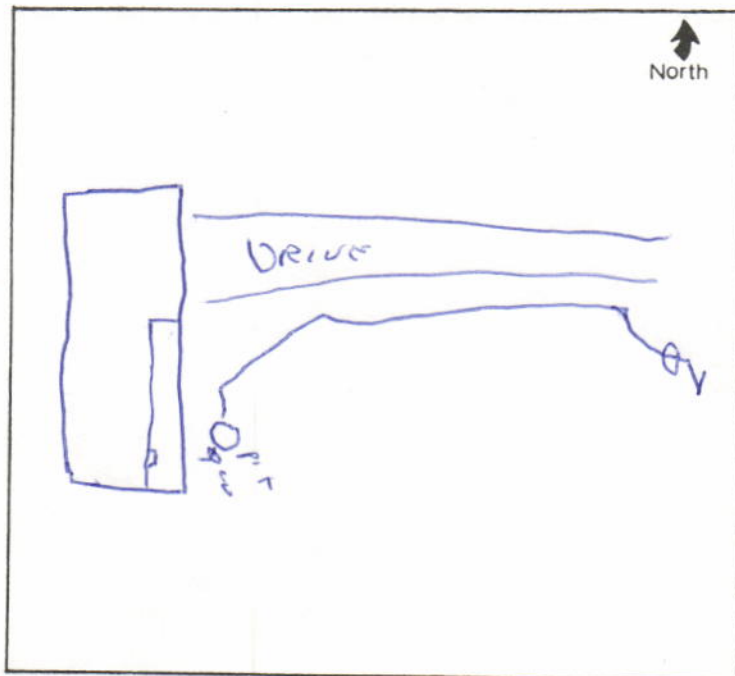

LONG & KOFFER, INC.
1795 W. HUNTSVILLE RD.
PENDLETON, INDIANA 46064
765/778-5219

NATIONAL CITY BANK
INDIANAPOLIS, INDIANA 46255
20-61740

9/14/2000

PAY TO THE
ORDER OF

Fall Creek Regional Waste District

\$2,049.60

Two-Thousand Forty-Nine Dollars and _____

60/100

DOLLARS

MEMO:

[Signature]

⑈001191⑈ ⑈074000065⑈

SECURITY FEATURES: MICRO PRINT TOP & BOTTOM BORDERS - COLORED PATTERN - ARTIFICIAL WATERMARK ON REVERSE SIDE - MISSING FEATURE INDICATES A COPY

grinder pumps
for Dante & Barbara

P

DANTE O. PHILLIPS
CONSTANCE B. PHILLIPS
PH. 765-649-5459
5363 SOUTH 100 WEST
ANDERSON, IN 46013

4580

DATE 10-2-06

71-7260/2749

PAY TO THE
ORDER OF

Fall Creek Regional Water

\$ 400.00

four hundred

DOLLARS

SECURITY
FEATURES INCLUDED
DETAILS ON BACK

Madison
County
Federal Credit Union
(765) 644-3623 Anderson, Indiana



MEMO

down payment for bridge

Dante Phillips

MP

⑆ 2749726051 ⑆

.580