

Side

PROJECT Phase II SHEET _____ OF _____


SUBJECT _____ DATE 5-31-18

JOB NO. 4447

BY Atlas

536 S. Pendleton

← N

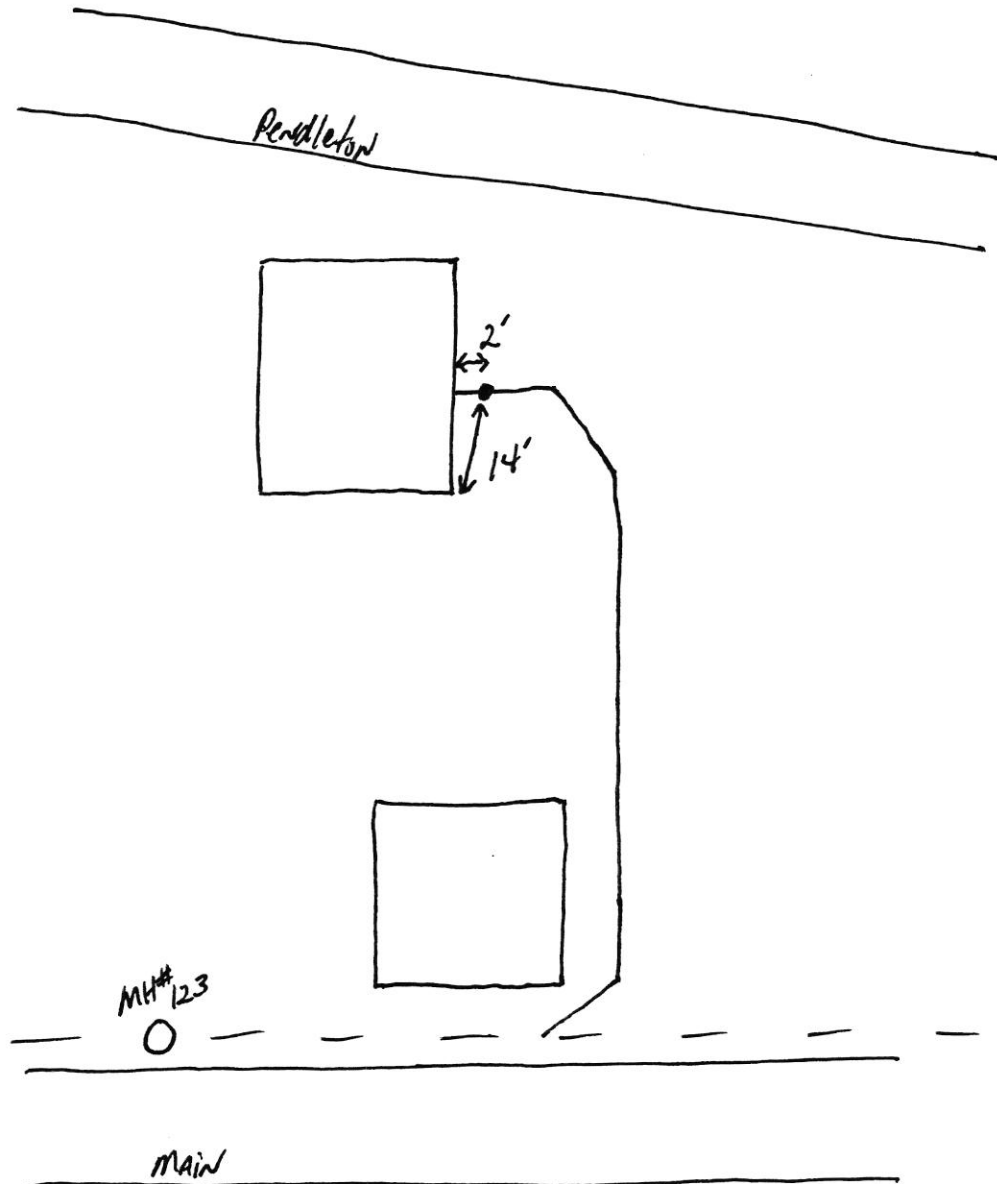

536 S Pendleton

SRF Phase II

6.11.18

