

Gidw.

PROJECT Phase II SHEET _____ OF _____


SUBJECT _____ DATE 6-5-18

JOB NO. 4447

BY Atlas

537 S. Pendleton

← N

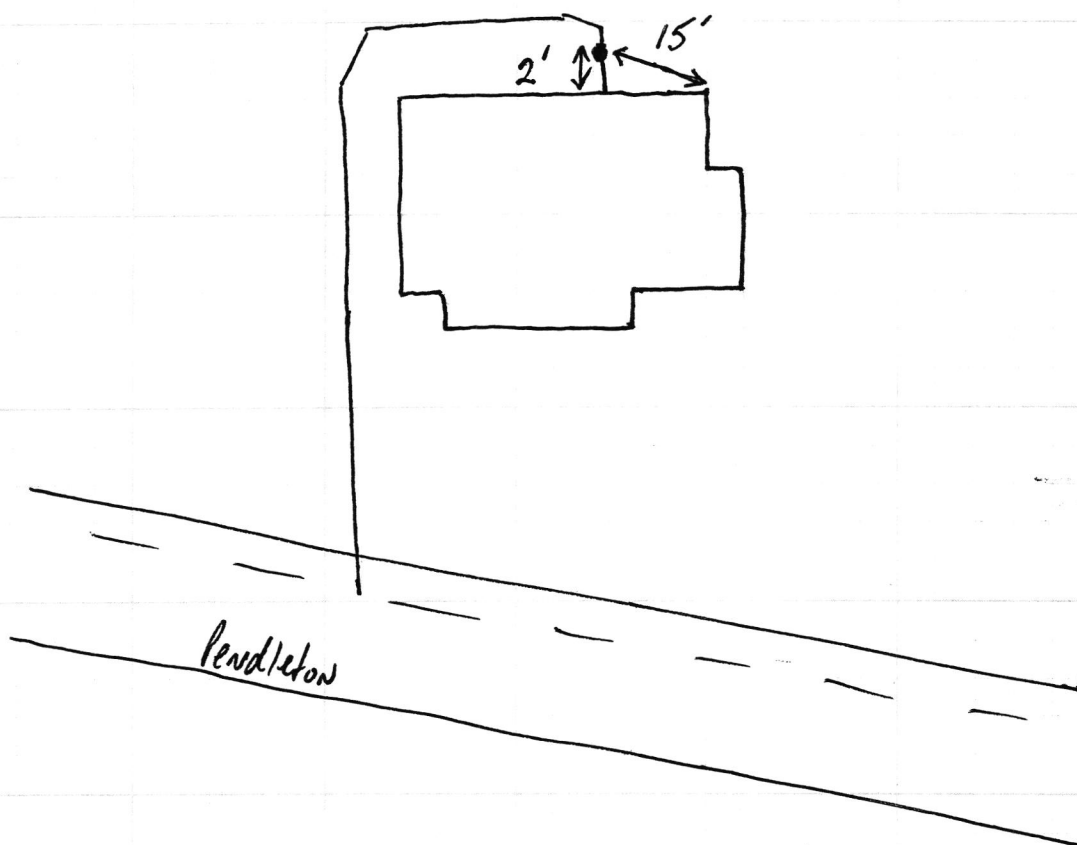

537 S Pendleton

SRF Phase II

6.11.18

