



FALL CREEK REGIONAL WASTE DISTRICT

9378 S. 650 West PO Box 59
Pendleton, IN 46064-0059 778-7544

add order
on file

Mustin Builders

13-30073.99

APPLICATION FOR SEWER PERMIT

Nº 2403

Date 8-19-96

Permit Void 90 days from Date of Issuance

Owner Name Mustin Builders Inc. 810 Central Ave. Anderson, IN. 46012

Property Address 544 Buck Lane

Lot # 3 P.O. Box _____

Town Pendleton, IN Zip Code 46064

Phone 317-644-8502 City Water ☒ Well _____

\$ 500.00 Tap on Fee Paid

\$ 25.00 Inspection fee paid

Application is hereby made for connection to the Fall Creek Regional Waste District Sewer System for the above listed property - Permit Type: Residential ☒, Commercial _____, Industrial _____, or Governmental/Institutional _____. User Information _____.

All workmanship and materials shall conform to the standards of the District Ordinance as described in Ordinance 84-2 and 84-3 as amended. Acceptance and approval must be made by the District inspector or his duly authorized representative before backfilling and final connection is made to the main sewer lines. Any violation of applicable regulations will cause all lines and appurtenances in violation to be removed and replaced at the owners expense.

The Fall Creek Regional Waste District is responsible for the inspection, approval of materials, and installation techniques only. All costs for materials and installation and any liabilities resulting from same is the sole responsibility of the property owner.

I have read and fully understand the above provisions and agree to comply by said provisions.

[Signature] Vice President Mustin Builders Inc.
APPLICANT(S) SIGNATURE

INSPECTOR _____

Date inspected _____ Approved _____ Rejected _____

Reason for rejection _____

Date reinspected _____ Approved _____ Rejected _____

Notes:

Size Pipe _____"

Type Pipe _____

Basement Yes _____ No _____

Sump Pump Yes _____ No _____

Downspout to Ground Yes _____ No _____

Septic Tank Pumped & filled Yes _____ No _____

Contractor _____

Special Conditions _____

Existing Home _____

New Construction _____



See Attached

MUSTIN BUILDERS, INC.

DATE	INVOICE NO.	DESCRIPTION	INVOICE AMOUNT	DEDUCTION	BALANCE
8-16-96	2403	sewer permit lot 3 BS	525.00	.00	525.00
CHECK DATE	CHECK NUMBER	TOTALS			
8-16-96	28254		525.00	.00	525.00

PLEASE DETACH THIS PORTION AND RETAIN FOR YOUR RECORDS



MUSTIN BUILDERS, INC.

810 CENTRAL AVENUE
ANDERSON, IN 46012
PH. 317-644-8502

SOCIETY NATIONAL BANK
ANDERSON, IN 46015
6-704-412

28254

Pay: Five hundred twenty-five dollars and no cents

DATE

CHECK NO.

AMOUNT

August 16, 1996

28254 *****525.00**


PAY
TO THE
ORDER
OF

FALL CREEK WASTE MGMT.
P. O. Box 59
County Road 650 West
Pendleton, IN 46064

Sidener

WATER, SEWER & INDUSTRIAL SUPPLIES

S IDENER
SUPPLIES
SATISFIED
SERVICE

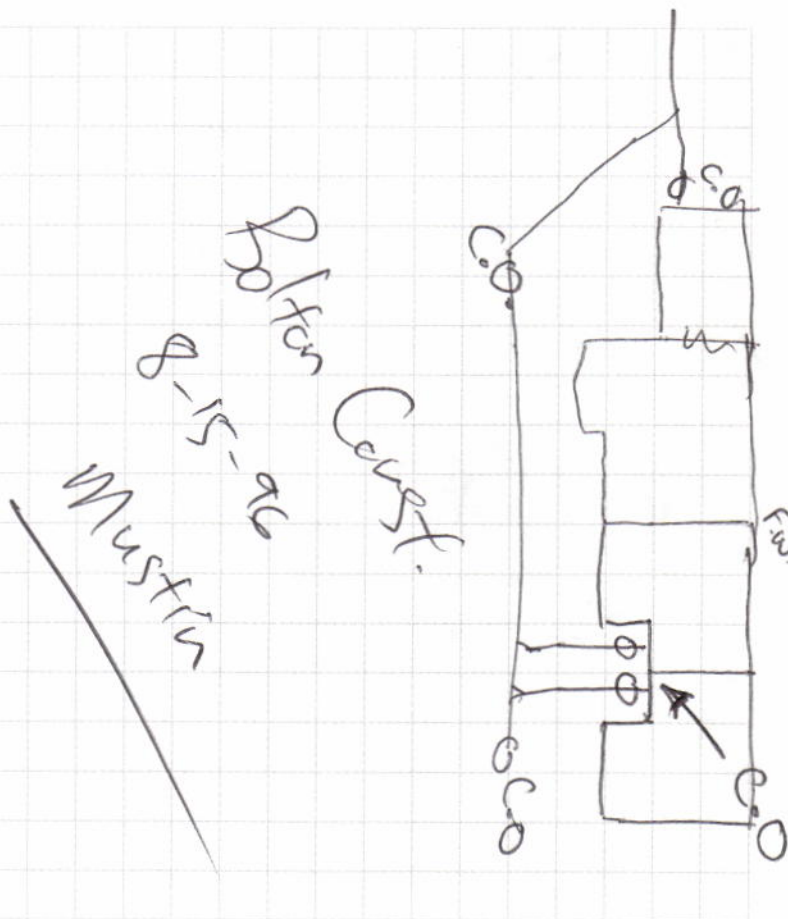

INDIANAPOLIS, INDIANA 46214

1680 Expo Lane

Phone: **317-271-1463**

Toll Free: **800-792-3461**

Fax: **317-271-2026**

OAKLANDON, INDIANA 46236

5858 Thunderbird Road

Phone: **317-823-4474**

Fax: **317-823-2363**

GREENWOOD, INDIANA 46142

1950 E. Main Street

Phone: **317-882-5715**

Fax: **317-882-5743**

LOCATIONS: MISSOURI, ILLINOIS, INDIANA, KANSAS, WISCONSIN