



# FALL CREEK REGIONAL WASTE DISTRICT

Box 44, Pendleton, Indiana 46064

22-05521.00  
Pratter

Now

2-0805521.00

Nº 001104

## APPLICATION FOR SEWER PERMIT

Permit No. \_\_\_\_\_ Date 1-2-86

Permit Void 90 days from Date of Issuance

Owner Name Ralston Pursley

Property Address R4 Box 443 - 8209 S Madison Ave

Lot # \_\_\_\_\_ P.O. Box 5525 S. 100 St.

Town ANDERSON, IN Zip Code 46013-9400

Phone 778-4601 Water Meter \_\_\_\_\_

\$ 150.00 Tap on Fee Paid

\$ 25.00 Inspection fee paid

Application is hereby made for connection to the Fall Creek Regional Waste District Sewer System for the above listed property - Permit Type: Residential ☒, Commercial \_\_\_\_\_, Industrial \_\_\_\_\_, or Governmental/Institutional \_\_\_\_\_. User Information \_\_\_\_\_.

All workmanship and materials shall conform to the standards of the District Ordinance as described in Ordinance 84-2 and 84-3 as amended. Acceptance and approval must be made by the District inspector or his duly authorized representative before backfilling and final connection is made to the main sewer lines. Any violation of applicable regulations will cause all lines and appurtenances in violation to be removed and replaced at the owners expense.

The Fall Creek Regional Waste District is responsible for the inspection, approval of materials, and installation techniques only. All costs for materials and installation and any liabilities resulting from same is the sole responsibility of the property owner.

I have read and fully understand the above provisions and agree to comply by said provisions.

Ralston V. Pursley

APPLICANT(S) SIGNATURE

\*\*\*\*\*

INSPECTOR [Signature]

Date inspected 1-24 Approved ☒ Rejected \_\_\_\_\_

Reason for rejection \_\_\_\_\_

Date reinspected \_\_\_\_\_ Approved \_\_\_\_\_ Rejected \_\_\_\_\_

Notes:

Size Pipe 6 "

Type Pipe PVC

Basement Yes \_\_\_\_\_ No ☒

Sump Pump Yes \_\_\_\_\_ No ☒


Downspout to Ground Yes ☒ No \_\_\_\_\_

Septic Tank Pumped & filled Yes ☒ No \_\_\_\_\_

Contractor PRATTER

Special Conditions LINE THROUGH

S.T.

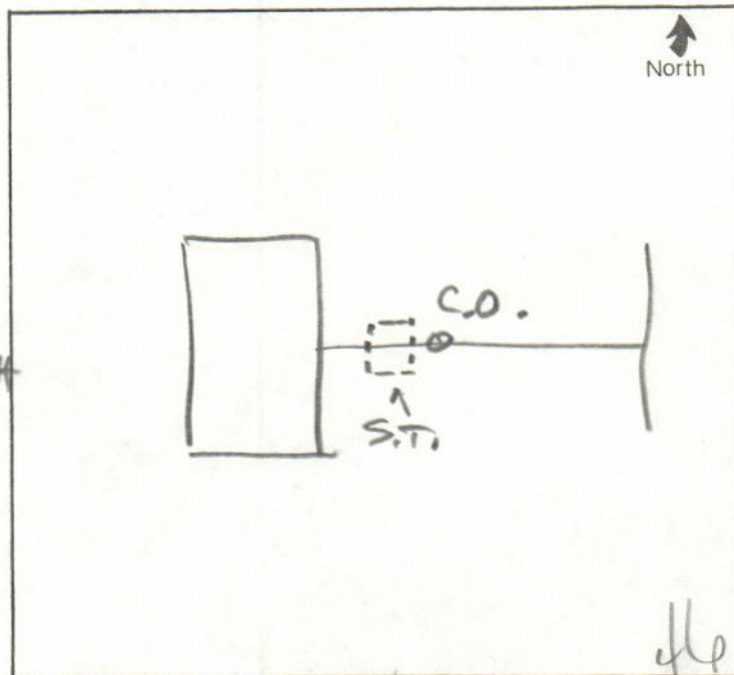

Could not find acct