

FALL CREEK REGIONAL WASTE DISTRICT

9378 S 650 WEST, P.O. BOX 59, PENDLETON, IN 46064

765-778-7544

AGREEMENT FOR SANITARY SEWER SERVICE

This Agreement made and entered into this 23<sup>rd</sup> day of May, 2002, between FALL CREEK REGIONAL WASTE DISTRICT ("District") and Sam Messer ("Applicant") regarding the provision of sanitary sewer service, and the assignment of capacity in, and connection to, the District's facilities for the premises located at 5529 W. Reformatory Road

NOW THEREFORE, the parties, in consideration of the mutual promises set out in this Agreement, the receipt and sufficiency of which is hereby acknowledged, agree as follows:

1. The Applicant agrees that all workmanship and materials shall conform to all District ordinances and the District's construction standards. District must accept and approve all work and materials before backfilling and final connection is made to the sewer mains. Any violation of this provision will cause all lines and appurtenances in violation to be removed and replaced at the Applicant's expense.
2. The District shall have the right to enter upon the Applicant's premises at all reasonable times to inspect, repair, or replace any equipment used in connection with the District's service or which has an impact on said service.
3. The Applicant shall be responsible for all monthly user rates, capacity charges, and tap fees. The failure to pay any rate charge or fee may result in a lien against the property and/or the termination of service to the property, the cost of which will be borne by Applicant, including, but not limited to, all attorney's fees and collection costs.
4. The District shall not be responsible for any damages as a result of any failure to supply service unless said damages are due to default, neglect or culpability on the part of the District.
5. If there is an available sanitary sewer within three hundred (300) feet of the property line, the property owner shall be required to connect to the District's sanitary sewer system.
6. The Applicant and District agree that the provision of sanitary sewer service touches and concerns the property and the terms of this Agreement bind the District and Applicant and their heirs, executors, administrators, personal representatives, successors, agents, attorneys, assigns, designees, and transferees.

The parties hereto have read and fully understand the above provisions and agree to comply with said provisions.

FALL CREEK REGIONAL WASTE DISTRICT

Signature

STATE OF INDIANA )

) SS:

COUNTY OF MADISON )

APPLICANT

Signature

SUBSCRIBED and sworn to before me this 23<sup>rd</sup> day of May, 2002.

My Commission Expires:

4-29-2009

Signature

Printed

Jan E. Carey  
Notary Public  
Resident of Madison County

\*\*\*\*\*

INSPECTOR Steve DATE INSPECTED 5/27/02 APPROVED ✓ REJECTED       

REASON FOR REJECTION       

DATE REINSPECTED        APPROVED        REJECTED       

NOTES: 4"/1 1/2 TYPE PIPE SDR 35 4"  
160 1 1/2

BASEMENT YES NO

SUMP PUMP YES NO

DOWNSPOUT TO GROUND YES NO


SEPTIC TANK PUMPED & FILLED YES NO

CONTRACTOR Messer (Home owner)

SPECIAL CONDITIONS       

EXISTING HOME ✓

NEW CONSTRUCTION       

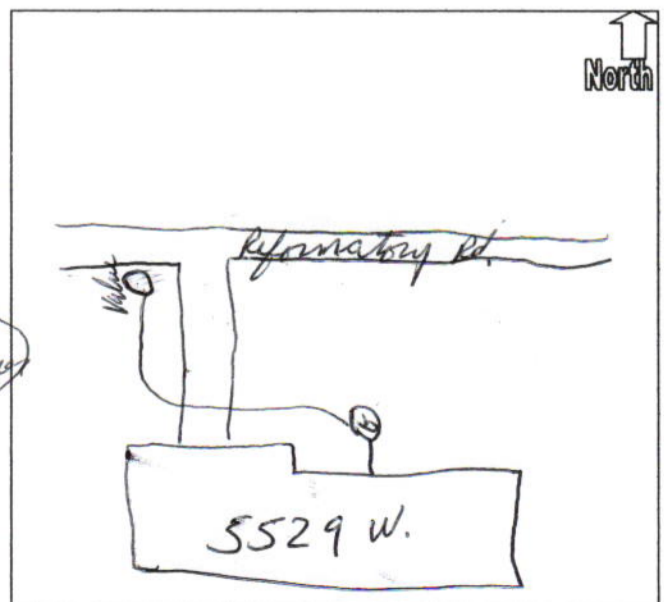

*Culy*

CONSTRUCTION & EXCAVATING, INC.

FEDERAL I.D. NO. 35-1626214  
610 N. 100 E. • P.O. BOX 29  
WINCHESTER, IN 47394  
(765) 584-8509

 **OLD NATIONAL**  
MEMBER OLD NATIONAL BANCORP  
71-1/863

018648

May 22, 2002

\$1,024.80

One Thousand Twenty Four Dollars And Eighty Cents\*\*\*\*\*

PAY  
TO THE  
ORDER OF

Fall Creek Regional Waste District

CULY CONSTRUCTION & EXCAVATING, INC.

  
AUTHORIZED SIGNATURE

MP

⑈018648⑈



# FALL CREEK REGIONAL WASTE DISTRICT

Box 44, Pendleton, Indiana 46064

*add order  
on file*

21-03540.00

## APPLICATION FOR SEWER PERMIT

Nº 001963

Permit No. \_\_\_\_\_ Date 11/15/93  
Permit Void 90 days from Date of Issuance  
Owner Name Randy & Tammy King  
Property Address 5529 W. Reformatory Rd  
Lot # \_\_\_\_\_ P.O. Box \_\_\_\_\_  
Town Fortville, IN Zip Code 46040  
Phone \_\_\_\_\_ Water Meter \_\_\_\_\_"  
\$ 700.00 (3/9/94) Tap on Fee Paid  
\$ 25.00 (3/9/94) Inspection fee paid

Application is hereby made for connection to the Fall Creek Regional Waste District Sewer System for the above listed property - Permit Type: Residential ☒, Commercial \_\_\_\_\_, Industrial \_\_\_\_\_, or Governmental/Institutional \_\_\_\_\_. User Information \_\_\_\_\_.

All workmanship and materials shall conform to the standards of the District Ordinance as described in Ordinance 84-2 and 84-3 as amended. Acceptance and approval must be made by the District inspector or his duly authorized representative before backfilling and final connection is made to the main sewer lines. Any violation of applicable regulations will cause all lines and appurtenances in violation to be removed and replaced at the owners expense.

The Fall Creek Regional Waste District is responsible for the inspection, approval of materials, and installation techniques only. All costs for materials and installation and any liabilities resulting from same is the sole responsibility of the property owner.

I have read and fully understand the above provisions and agree to comply by said provisions.

Randy King Tammy King  
APPLICANT(S) SIGNATURE

\*\*\*\*\*

INSPECTOR \_\_\_\_\_

Date inspected \_\_\_\_\_ Approved \_\_\_\_\_ Rejected \_\_\_\_\_

Reason for rejection \_\_\_\_\_

Date reinspected \_\_\_\_\_ Approved \_\_\_\_\_ Rejected \_\_\_\_\_

### Notes:

Size Pipe \_\_\_\_\_"

Type Pipe \_\_\_\_\_

Basement Yes \_\_\_\_\_ No \_\_\_\_\_

Sump Pump Yes \_\_\_\_\_ No \_\_\_\_\_

Downspout to Ground Yes \_\_\_\_\_ No \_\_\_\_\_

Septic Tank Pumped & filled Yes \_\_\_\_\_ No \_\_\_\_\_


Contractor \_\_\_\_\_

Special Conditions \_\_\_\_\_



SAMUEL H MESSER, III  
JAMIE MESSER  
5529 W REFORMATORY RD  
FORTVILLE, IN 46040  
PH 778-0434

DATE 5-28-02 1616  
20-7413/2740

PAY TO THE ORDER OF F.C.R.W.D. \$ 50.00  
Fifty 00/100 DOLLARS  Security Features  
Detailed On Back

**ff Harvester**  
Federal Credit Union  
Indianapolis, IN 46239

R&T 274074134 ACCT 18259

MEMO \_\_\_\_\_

Samuel H. Messer III

⑆274074134⑆

1616

© 1999 ENTERPRISES INC. 000