


Gidw.

PROJECT Phase II SHEET _____ OF _____

SUBJECT _____ DATE 2-26-18

JOB NO. 4447

BY At/as

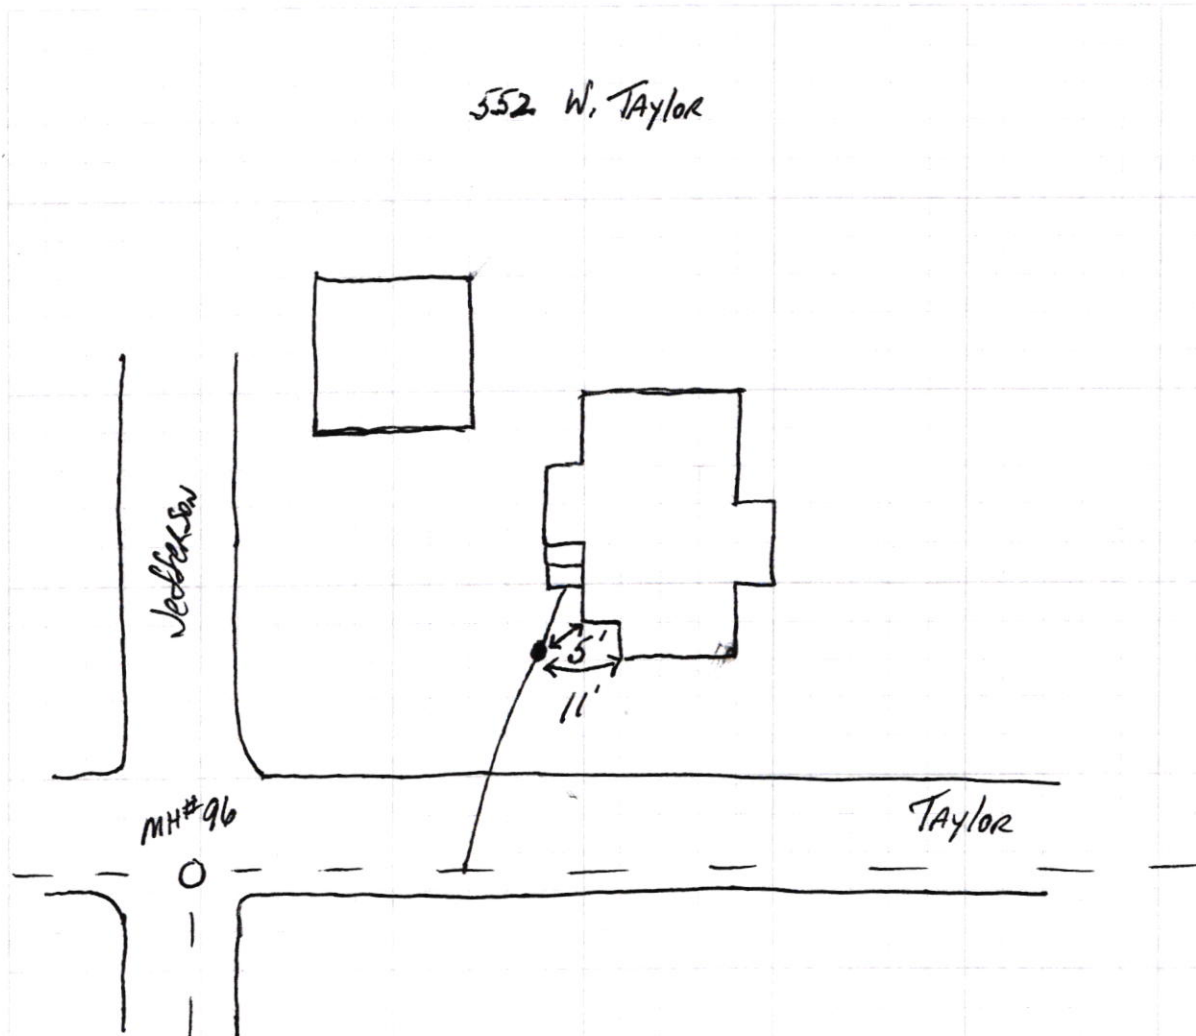

522 W Taylor
552?

SRF Phase II

