



FALL CREEK REGIONAL WASTE DISTRICT

Box 44, Pendleton, Indiana 46064

10-23120.02

3-1023120.01  
Jane Wayfel

APPLICATION FOR SEWER PERMIT

Nº 001647

Permit No. 1647 Date 7-26-88

Permit Void 90 days from Date of Issuance

Owner Name

BUILDER: Roy Willis

Property Address 554 EAST WATER ST

P.O. Box 526

Lot #

P.O. Box

ANDERSON, IND

Town PENDLETON

, IN

Zip Code

46064

46015

Phone

Water Meter

"

\$ 500.00 Tap on Fee Paid

\$ 25.00 Inspection fee paid

Application is hereby made for connection to the Fall Creek Regional Waste District Sewer System for the above listed property - Permit Type: Residential X, Commercial     , Industrial     , or Governmental/Institutional     . User Information     .

All workmanship and materials shall conform to the standards of the District Ordinance as described in Ordinance 84-2 and 84-3 as amended. Acceptance and approval must be made by the District inspector or his duly authorized representative before backfilling and final connection is made to the main sewer lines. Any violation of applicable regulations will cause all lines and appurtenances in violation to be removed and replaced at the owners expense.

The Fall Creek Regional Waste District is responsible for the inspection, approval of materials, and installation techniques only. All costs for materials and installation and any liabilities resulting from same is the sole responsibility of the property owner.

I have read and fully understand the above provisions and agree to comply by said provisions.

Roy Willis  
APPLICANT(S) SIGNATURE

INSPECTOR BP

Date inspected 7-8-88 Approved ✓ Rejected     

Reason for rejection     

Date reinspected      Approved      Rejected     

Notes:

Size Pipe 6 "

Type Pipe PVC

Basement Yes      No X

Sump Pump Yes      No X


Downspout to Ground Yes X No     

Septic Tank Pumped & filled Yes N/A

Contractor BOCK GOODEY

Special Conditions ATTACHED TO

McCURDY LATRINE

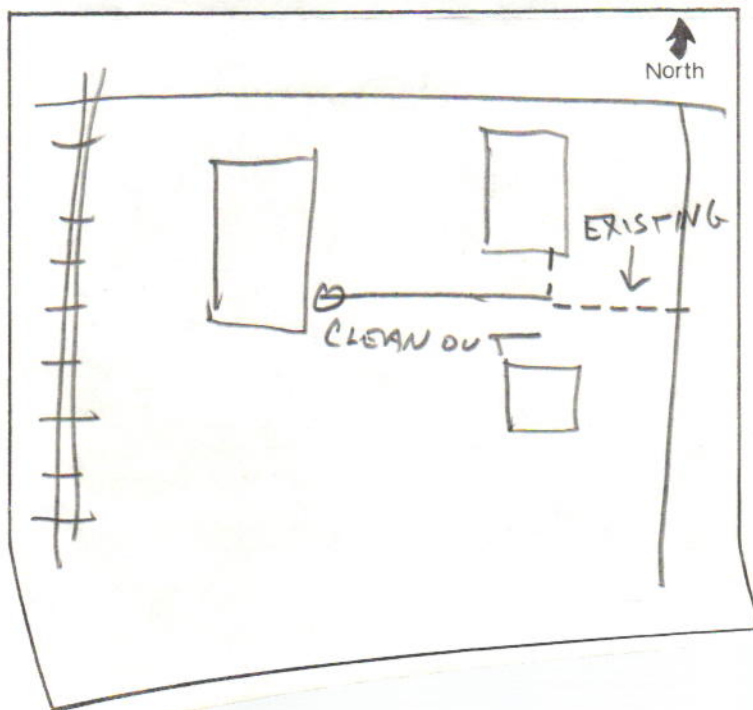

To

Andy Willis

P.O. Box 526

(Also 1519 Chesterfield)

Anderson, IN 46015

# Fall Creek Regional Waste District

P.O. Box 59, C.R. 650 West  
Pendleton, Indiana 46064-0059  
(317) 778-3983

Subject

TAP/INSP FEE

643-2382

Date

7/26/88

## MESSAGE

Rec'd 7/23/88

ATTACHED IS ORIGINAL OF SEWER PERMIT. PLEASE SIGN AS APPLICANT AND RETURN WHITE COPY ALONG WITH THE TAP AND INSPECTION FEE OF \$525.<sup>00</sup> TO THIS OFFICE.

THE TAP/INSP FEE IS TO BE PAID PRIOR TO CONNECTION INTO THE DISTRICT COLLECTION SYSTEM.

NO SEWER BILLS WILL COMMENCE UNTIL THIS HOME IS OCCUPIED. PLEASE ADVISE THIS OFFICE WHEN HOME IS SOLD AND NAME OF BUYER.

Signed

THANKS  
DOR





FALL CREEK REGIONAL WASTE DISTRICT

Box 44, Pendleton, Indiana 46064

APPLICATION FOR SEWER PERMIT

Nº 001647

Permit No. 1647 Date 7-26-88

Permit Void 90 days from Date of Issuance

Owner Name BUILDER: Roy Willis

Property Address 554 EAST WATER ST P.O. Box 526

Lot # \_\_\_\_\_ P.O. Box ANDERSON, IND 46015

Town PEWOLETON, IN Zip Code 46064

Phone \_\_\_\_\_ Water Meter \_\_\_\_\_

\$ \_\_\_\_\_ Tap on Fee Paid

\$ \_\_\_\_\_ Inspection fee paid

Application is hereby made for connection to the Fall Creek Regional Waste District Sewer System for the above listed property - Permit Type: Residential X, Commercial \_\_\_\_\_, Industrial \_\_\_\_\_, or Governmental/Institutional \_\_\_\_\_. User Information \_\_\_\_\_.

All workmanship and materials shall conform to the standards of the District Ordinance as described in Ordinance 84-2 and 84-3 as amended. Acceptance and approval must be made by the District inspector or his duly authorized representative before backfilling and final connection is made to the main sewer lines. Any violation of applicable regulations will cause all lines and appurtenances in violation to be removed and replaced at the owners expense.

The Fall Creek Regional Waste District is responsible for the inspection, approval of materials, and installation techniques only. All costs for materials and installation and any liabilities resulting from same is the sole responsibility of the property owner.

I have read and fully understand the above provisions and agree to comply by said provisions.

APPLICANT(S) SIGNATURE

\*\*\*\*\*

INSPECTOR BP

Date inspected 7-8-88 Approved ✓ Rejected \_\_\_\_\_

Reason for rejection \_\_\_\_\_

Date reinspected \_\_\_\_\_ Approved \_\_\_\_\_ Rejected \_\_\_\_\_

Notes:

Size Pipe 6 "

Type Pipe PVC

Basement Yes \_\_\_\_\_ No X

Sump Pump Yes \_\_\_\_\_ No X


Downspout to Ground Yes X No \_\_\_\_\_

Septic Tank Pumped & filled Yes N/A No \_\_\_\_\_

Contractor BOCK GOOBEL

Special Conditions ATTACHED TO

McCurdy LATRINE

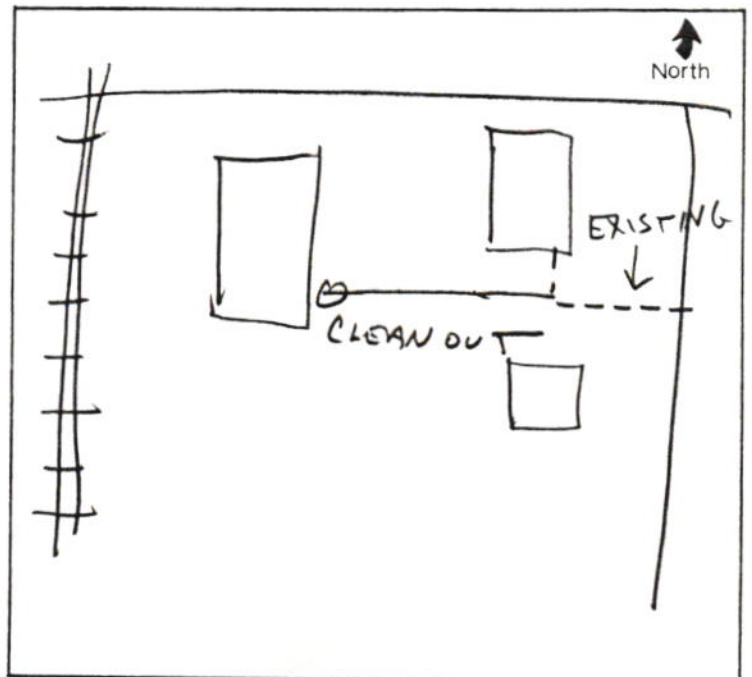

Dad -

7-8-88

Dick Godbey installed a tap ~~on~~ on vacant lot (Water St) next to viaduct. He connected this into McCurdy's Rental. It was for a Willets or Willis.

Do you know any thing about this? Can't find record of tap & insp being paid.

Lusa

T.

Attachment is my communication with Roy Willis,

Tap Fee is \$500

INSP/ADMIN

25

\$525 TOTAL.

We Need to Have Ben Check this and draw insp report - we need to contact Godbey. - (LEFT MESSAGE 7-11-88)

Dad

6-14-88

ROY WILLIS  
WATER ST

BOUGHT LOT FROM OWNERS  
BY MORRIS MCLEARY'S ROUTE  
(BY RAILROAD)

