

Gidw.

PROJECT Phase II SHEET _____ OF _____


SUBJECT _____ DATE 6-4-18

JOB NO. 4447

BY Atlas

555 S. Pendleton

← N

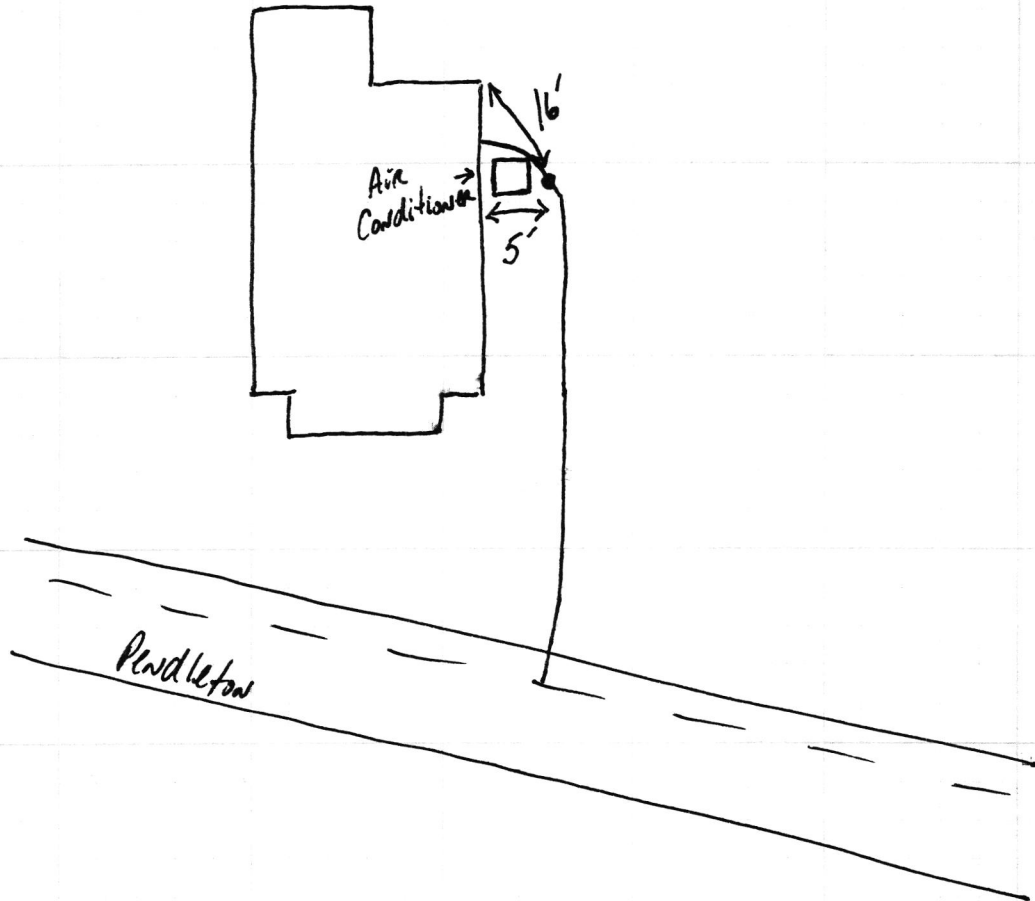

SSS S Penetration

SAP Phase II

Co. 11.18

