

Gidw.

PROJECT

Phase II

SHEET

OF

SUBJECT


DATE 6-2-18

JOB NO. 4447

BY Atlas

559 S. Pendleton

← N

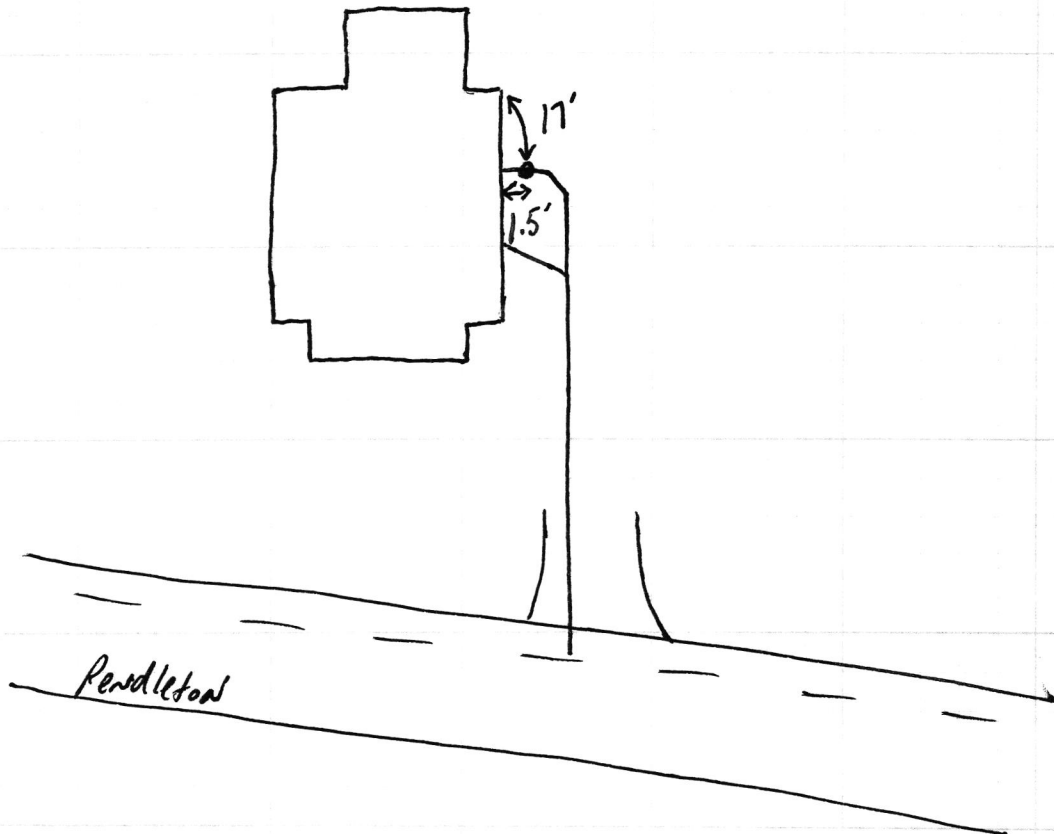

559 s Renduhton

SRF Phase II

Co.11.18

