

Gidw.

PROJECT Phase II SHEET _____ OF _____


SUBJECT _____ DATE 6-1-18

JOB NO. 4447

BY Atlas

563 S. Pendleton

← N

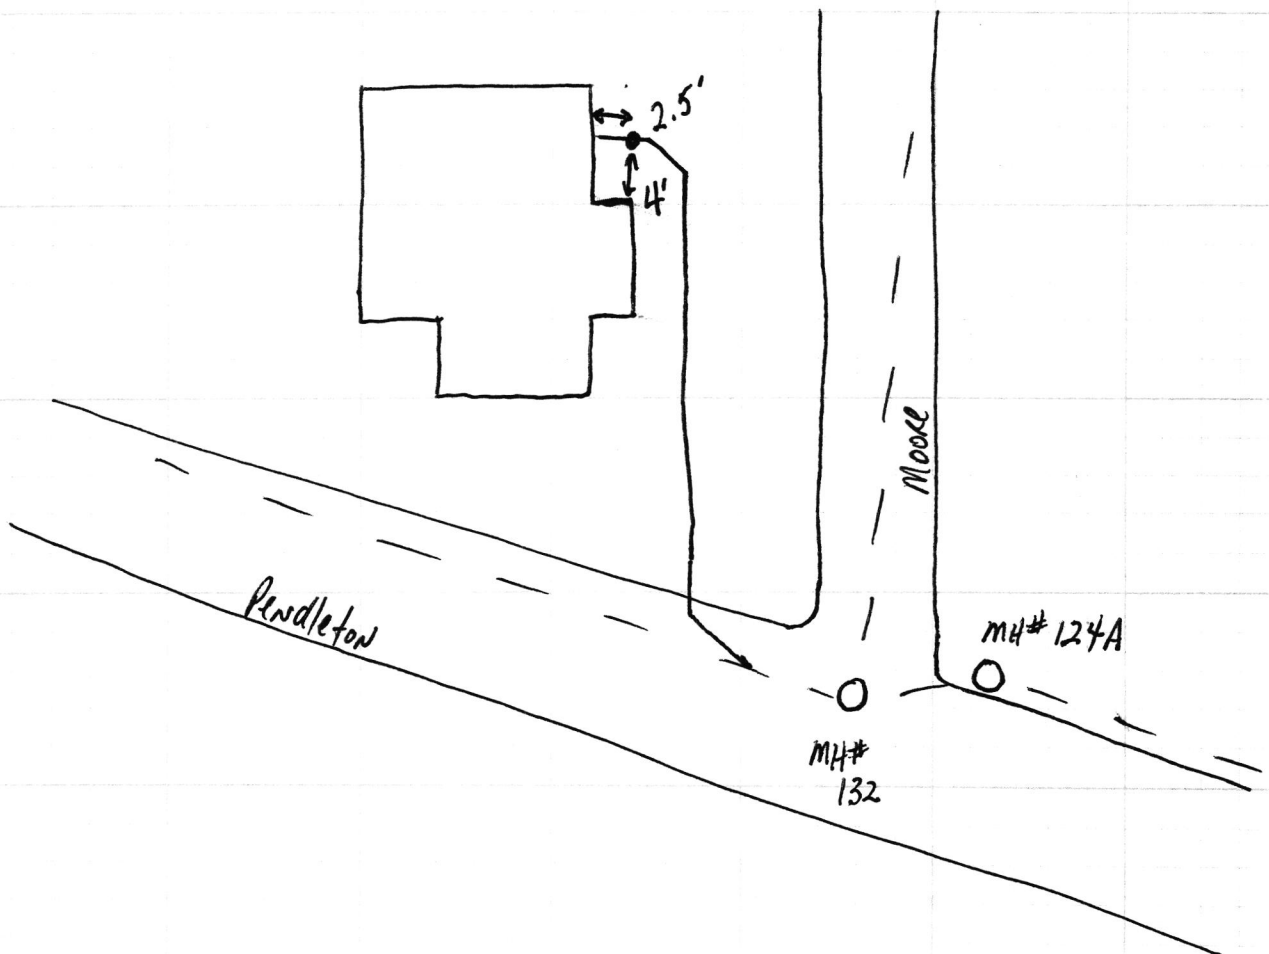

SLO3 S Penetration

SRF Phase II

6.11.18

