

#6985

This Agreement made and entered into this 6 day of September, 2019, between Fall Creek Regional Waste District ("District") and Robert Ruffey ("Applicant") regarding the provision of sanitary sewer service, and the assignment of capacity in and connection to, the District's facilities for the premises located at _____

Now therefore, the parties, in consideration of the mutual promises set out in this Agreement, the receipt and sufficiency of which is hereby acknowledged, agree as follows:


1. The Applicant agrees that all workmanship and materials shall conform to all District ordinances and the District's construction standards. District must accept and approve all work and materials before backfilling and final connection is made to the sewer mains. Any violation of this provision will cause all lines and appurtenances in violation to be removed and replaced at the Applicant's expense.
2. The District shall have the right to enter upon the Applicant's premises at all reasonable times to inspect, repair, or replace any equipment used in connection with the District's service or which has an impact on said service.
3. The Applicant shall be responsible for all monthly user rates, capacity charges, and tap fees. The failure to pay any rate charge or fee may result in a lien against the property and/or the termination of service to the property, the cost of which will be borne by Applicant, including, but not limited to, all attorney's fees and collection costs.
4. The District shall not be responsible for any damages as a result of any failure to supply service unless said damages are due to default, neglect or culpability on the part of the District.
5. If there is an available sanitary sewer within three hundred (300) feet of the property line, the property owner shall be required to connect to the District's sanitary sewer system.
6. The Applicant and District agree that the provision of sanitary sewer service touches and concerns the property and the terms of this Agreement bind the District and Applicant and their heirs, executors, administrators, personal representatives, successors, agents, attorneys, assigns, designees, and transferees.

FALL CREEK REGIONAL WASTE DISTRICT
Signature

Signature

[illegible]

SUBSCRIBED and sworn to before me this 6 day of September, 2019

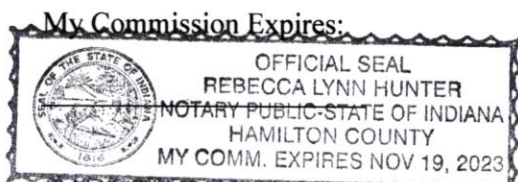

Signature _____

Printed

Notary Public

Resident of Hamilton County

Inspector SM Date Inspected 10-2-19 Approved X Rejected _____
Reason for Rejection _____

Date Reinspected _____ Approved _____ Rejected _____

Notes:

Size Pipe 4" 1/2 Type Pipe 60R IPS

Basement Yes No

Sump Pump Yes No

Downspout to Ground Yes No


Septic Tank Pumped & Filled Yes No

Contractor Riffes

Special Conditions

Existing Home ☒

New Construction

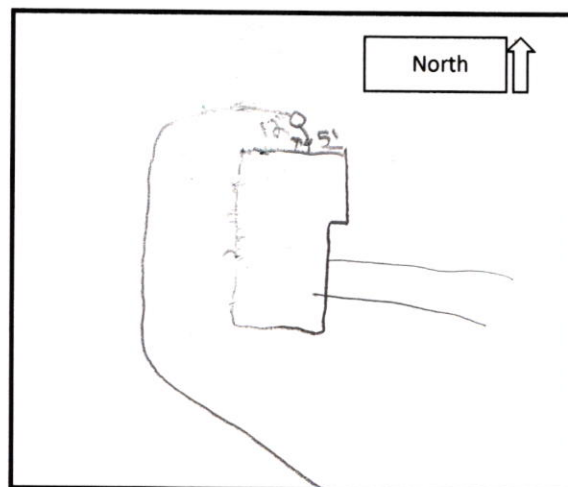

1 picture attached

5701 S 425 W

sean mitchel

10-2-19



COPY

FALL CREEK REGIONAL WASTE DISTRI
9378 S 650 W
PO BOX 59
PENDLETON, IN 46064
765-778-7544

FALL CREEK REGIONAL WASTE DIST
0005560008022120839000

Date: 09/06/2019 11:27:30 AM

CREDIT CARD SALE

Receipt #11017

VISA

CARD NUMBER: *****3768 K

TRAN AMOUNT: \$6,937.38

APPROVAL CD: 01908G

ECI:

RECORD #: 000

CLERK ID: Becca

SALES TAX: \$0.00

INVOICE #: 5701 S 425 FEES

x

Robert Riffey

I AGREE TO PAY THE ABOVE TOTAL AMOUNT
ACCORDING TO THE CARD ISSUER AGREEMENT
(MERCHANT AGREEMENT IF CREDIT VOUCHER)

Thank you for your business!

Merchant Copy

Capacity \$2800.00
Tap \$570.00
Grinder \$3567.38
Unit \$3334.00
Tax \$233.38