

FALL CREEK REGIONAL WASTE DISTRICT

9378 S 650 WEST, P.O. BOX 59, PENDLETON, IN 46064

765-778-7544

AGREEMENT FOR SANITARY SEWER SERVICE

add order
on file

4195

26-02480.00

This Agreement made and entered into this 27th day of March, 2001, between FALL CREEK REGIONAL WASTE DISTRICT ("District") and Alan & Mary Held ("Applicant") regarding the provision of sanitary sewer service, and the assignment of capacity in, and connection to, the District's facilities for the premises located at 5710 Douglas Way.

NOW THEREFORE, the parties, in consideration of the mutual promises set out in this Agreement, the receipt and sufficiency of which is hereby acknowledged, agree as follows:

1. The Applicant agrees that all workmanship and materials shall conform to all District ordinances and the District's construction standards. District must accept and approve all work and materials before backfilling and final connection is made to the sewer mains. Any violation of this provision will cause all lines and appurtenances in violation to be removed and replaced at the Applicant's expense.
2. The District shall have the right to enter upon the Applicant's premises at all reasonable times to inspect, repair, or replace any equipment used in connection with the District's service or which has an impact on said service.
3. The Applicant shall be responsible for all monthly user rates, capacity charges, and tap fees. The failure to pay any rate charge or fee may result in a lien against the property and/or the termination of service to the property, the cost of which will be borne by Applicant, including, but not limited to, all attorney's fees and collection costs.
4. The District shall not be responsible for any damages as a result of any failure to supply service unless said damages are due to default, neglect or culpability on the part of the District.
5. If there is an available sanitary sewer within three hundred (300) feet of the property line, the property owner shall be required to connect to the District's sanitary sewer system.
6. The Applicant and District agree that the provision of sanitary sewer service touches and concerns the property and the terms of this Agreement bind the District and Applicant and their heirs, executors, administrators, personal representatives, successors, agents, attorneys, assigns, designees, and transferees.

The parties hereto have read and fully understand the above provisions and agree to comply with said provisions.

FALL CREEK REGIONAL WASTE DISTRICT

Signature Jan Carey

APPLICANT

Signature Mary J. Held

STATE OF INDIANA)
) SS:
COUNTY OF MADISON)

SUBSCRIBED and sworn to before me this 27th day of March, 2001.

My Commission Expires:

4-19-2008

Signature Teresa K Hutton

Printed Teresa K Hutton

Notary Public

Resident of Madison County

INSPECTOR Be DATE INSPECTED 4-5-01 APPROVED ✓ REJECTED _____

REASON FOR REJECTION _____

DATE REINSPECTED _____ APPROVED _____ REJECTED _____

NOTES:

SIZE PIPE 6" TYPE PIPE 35

BASEMENT YES _____ NO X

SUMP PUMP YES _____ NO X

DOWNSPOUT TO GROUND YES X NO Hayden


SEPTIC TANK PUMPED & FILLED YES ✓ NO _____

CONTRACTOR Gerdy

SPECIAL CONDITIONS _____

EXISTING HOME X

NEW CONSTRUCTION _____

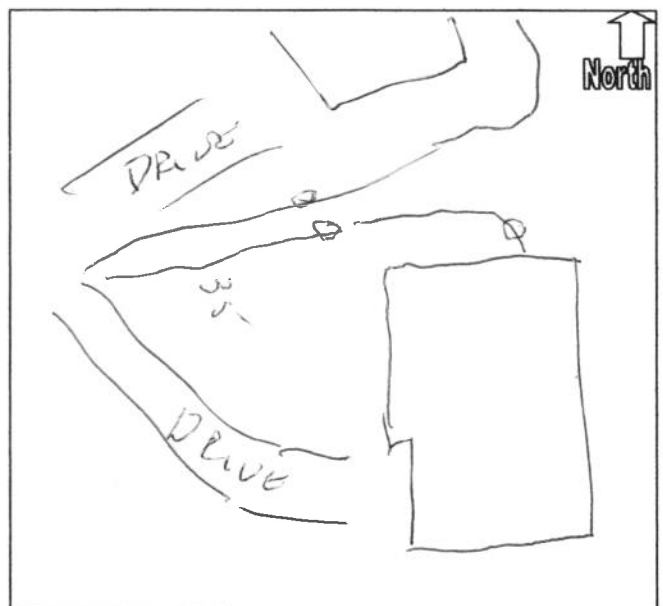

1000 Green
on file

PAUL GREEN HORTON WASTEWATER TREATMENT PLANT

1000 Green on file

1000 Green on file

Alan H. Held, Jr. 06-96
Mary F. Held
5710 Douglas Way 765-778-4196
Anderson, In 46013

3905

20-6740 308

3-27-01 Date

Pay to the Order of Fall Creek Regional Waste District \$ 1899.60

INTERMEZZO
© 1994

One thousand eight hundred ninety-nine and 60/100 Dollars



Security
Feature
Details
Back

National City.

National City Bank of Indiana
Anderson, Indiana

For Tap & Capacity Fee

Mary F. Held

1:074000065:

519668373

3905