



FALL CREEK REGIONAL WASTE DISTRICT

9378 S. 650 West PO Box 59
Pendleton, IN 46064-0059 778-7544

21-03568.00

APPLICATION FOR SEWER PERMIT

Nº 2437

Date 11/21/96

Permit Void 90 days from Date of Issuance

Owner Name LeRoy McBee

Property Address 5715 W Reformatory Road

Lot # _____ P.O. Box _____

Town Fortville, IN Zip Code 46040

Phone _____ City Water _____ Well _____

\$ 400 Tap on Fee Paid

\$ 2485.00 Capacity inspection fee paid 11/1/97

Application is hereby made for connection to the Fall Creek Regional Waste District Sewer System for the above listed property - Permit Type: Residential ☒, Commercial _____, Industrial _____, or Governmental/Institutional _____. User Information _____.

All workmanship and materials shall conform to the standards of the District Ordinance as described in Ordinance 84-2 and 84-3 as amended. Acceptance and approval must be made by the District inspector or his duly authorized representative before backfilling and final connection is made to the main sewer lines. Any violation of applicable regulations will cause all lines and appurtenances in violation to be removed and replaced at the owners expense.

The Fall Creek Regional Waste District is responsible for the inspection, approval of materials, and installation techniques only. All costs for materials and installation and any liabilities resulting from same is the sole responsibility of the property owner.

I have read and fully understand the above provisions and agree to comply by said provisions.

LeRoy McBee

APPLICANT(S) SIGNATURE

INSPECTOR B

Date inspected 11-10-97 Approved ☒ Rejected _____

Reason for rejection _____

Date reinspected _____ Approved _____ Rejected _____

Notes:

Size Pipe 6"

Type Pipe PVC

Basement Yes No ☒

Sump Pump Yes No ☒

Downspout to Ground Yes ☒ No _____


Septic Tank Pumped & filled Yes No ☒

Contractor Self

Special Conditions _____

Existing Home ☒

New Construction _____

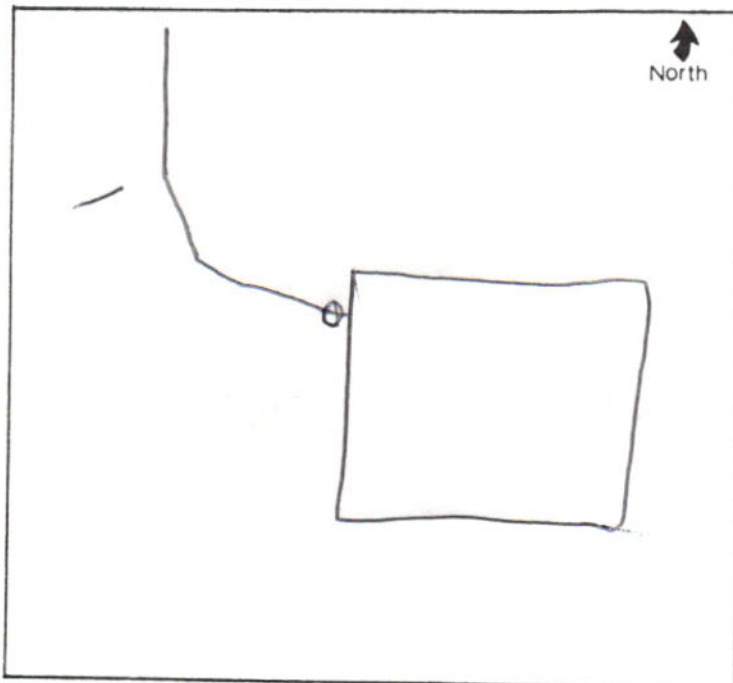



FALL CREEK REGIONAL WASTE DISTRICT

P.O. Box 59 • 9378 S. 650 West • Pendleton, Indiana 46064-0059 • (317) 778-7544

Bean Ball and L & B Floral are on one meter. Pendleton has two separate account numbers. Bean Ball is billed for the consumption and one base rate for water and sewer. L & B is billed for a base rate for water and sewer.

Bob Post Antiques, Myers Dime Store and Leo Post are on one meter. Myers and LeoPost are not billed water or sewer. Bob Post Antiques is billed for three base rates plus consumption for water. Bob Post Antiques is billed one base plus consumption for sewer.

L & B

\$505

- *CANCEL/REMOVE L & B FLORAL FROM CUSTOMER BILLING*
- *Credit 5715 Reformation Rd. Fortville*
\$400
TAP FEE
- *REFUND ^{\$}105 to Mr. LEROY MCGEE*

check for \$105
mailed 12/18/96.

JV Zoulet
11/21/96