

add Order  
on file

4068

# FALL CREEK REGIONAL WASTE DISTRICT

9378 S 650 WEST, P.O. BOX 59, PENDLETON, IN 46064

765-778-7544

26-02650.00

## AGREEMENT FOR SANITARY SEWER SERVICE

This Agreement made and entered into this 5<sup>th</sup> day of March, 2001, between FALL CREEK REGIONAL WASTE DISTRICT ("District") and Michael + Martha Godleski Applicant") regarding the provision of sanitary sewer service, and the assignment of capacity in, and connection to, the District's facilities for the premises located at 5730 Fairlee Road

**NOW THEREFORE**, the parties, in consideration of the mutual promises set out in this Agreement, the receipt and sufficiency of which is hereby acknowledged, agree as follows:

1. The Applicant agrees that all workmanship and materials shall conform to all District ordinances and the District's construction standards. District must accept and approve all work and materials before backfilling and final connection is made to the sewer mains. Any violation of this provision will cause all lines and appurtenances in violation to be removed and replaced at the Applicant's expense.
2. The District shall have the right to enter upon the Applicant's premises at all reasonable times to inspect, repair, or replace any equipment used in connection with the District's service or which has an impact on said service.
3. The Applicant shall be responsible for all monthly user rates, capacity charges, and tap fees. The failure to pay any rate charge or fee may result in a lien against the property and/or the termination of service to the property, the cost of which will be borne by Applicant, including, but not limited to, all attorney's fees and collection costs.
4. The District shall not be responsible for any damages as a result of any failure to supply service unless said damages are due to default, neglect or culpability on the part of the District.
5. If there is an available sanitary sewer within three hundred (300) feet of the property line, the property owner shall be required to connect to the District's sanitary sewer system.
6. The Applicant and District agree that the provision of sanitary sewer service touches and concerns the property and the terms of this Agreement bind the District and Applicant and their heirs, executors, administrators, personal representatives, successors, agents, attorneys, assigns, designees, and transferees.

The parties hereto have read and fully understand the above provisions and agree to comply with said provisions.

FALL CREEK REGIONAL WASTE DISTRICT

Signature Libbie Wilson

APPLICANT

Signature Michael Godleski

STATE OF INDIANA )

) SS:

COUNTY OF MADISON )

SUBSCRIBED and sworn to before me this 5<sup>th</sup> day of March, 2001.

My Commission Expires:

2-20-08

Signature Deborah L. Wilson

Printed Deborah L. Wilson

Notary Public

Resident of Madison County

\*\*\*\*\*

INSPECTOR Steve DATE INSPECTED 3/27/01 APPROVED ✓ REJECTED \_\_\_\_\_

REASON FOR REJECTION \_\_\_\_\_

DATE REINSPECTED \_\_\_\_\_ APPROVED \_\_\_\_\_ REJECTED \_\_\_\_\_

NOTES:

SIZE PIPE 6" TYPE PIPE SDR35

BASEMENT (YES) NO \_\_\_\_\_

SUMP PUMP YES (NO)

DOWNSPOUT TO GROUND (YES) NO \_\_\_\_\_


SEPTIC TANK PUMPED & FILLED (YES) Daider NO \_\_\_\_\_

CONTRACTOR Zeds Plumbing

SPECIAL CONDITIONS \_\_\_\_\_

EXISTING HOME ✓

NEW CONSTRUCTION \_\_\_\_\_

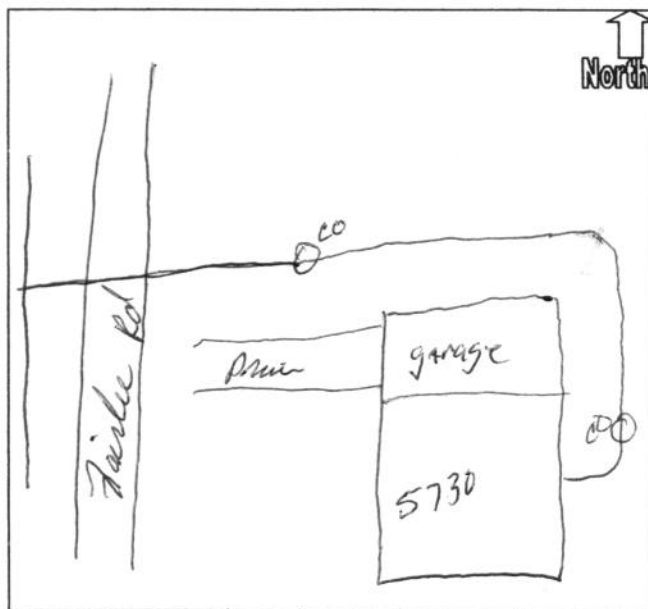

Michael Godleski 11/80  
Martha R. Godleski  
PH: 765-778-3876  
5730 S. Fairlee Rd.  
Anderson, IN 46013

6391

71-7257/2749

Date

3/3/01

Pay To The Order Of FALL CREEK REGIONAL WASTE DIST \$ 1926 <sup>95</sup>/<sub>XX</sub>  
One Thousand Nine Hundred Twenty Six <sup>95</sup>/<sub>XX</sub> Dollars

INDEPENDENT FEDERAL CREDIT UNION  
ANDERSON, INDIANA 46016

Security features  
included.  
Details on back.

For

26-02650-00

Booster  
People  
Gutmann

Michael Godleski

MP

⑆274972579⑆

0136234 6391

© DESIGNER CHECKS - ANGEL "CAUGHT NAPPING"

© THE BALLJOL CORPORATION