


add order  
on file

26-02670.00

## AGREEMENT FOR SANITARY SEWER SERVICE

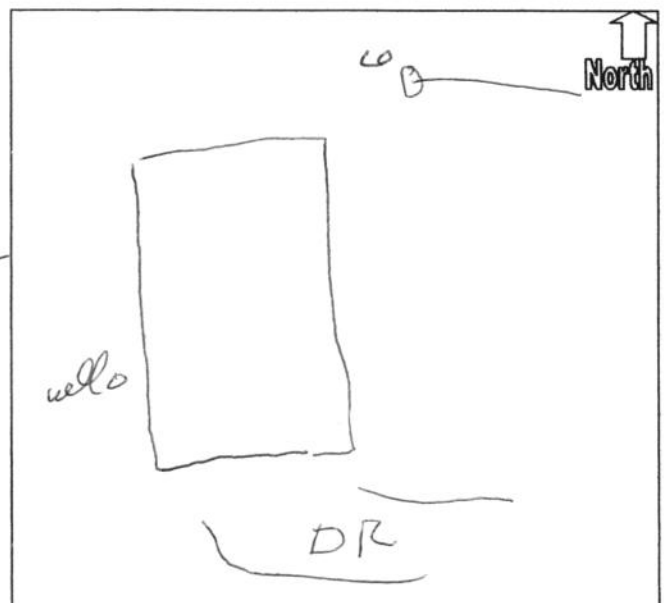

JAMES E CLEGG 12-96  
5755 FAIRLEE RD, PH (765) 778-8245  
ANDERSON, IN 46013-9766

DATE 4/16/01

1301

71-167749  
BRANCH 10006

PAY TO THE  
ORDER OF

Fall Creek Regional Waste District

\$ 1,872.25

One Thousand & Eight Hundred Seventy Two - <sup>25</sup>/<sub>100</sub> DOLLARS

 Security features  
included.  
Details on back.



FOR

James E Clegg

MP

⑆074901672⑆ 1301 ⑈122 11598⑈

© HARLAND 1998