

FALL CREEK REGIONAL WASTE DISTRICT

9378 S 650 WEST, P.O. BOX 59, PENDLETON, IN 46064  
765-778-7544

AGREEMENT FOR SANITARY SEWER SERVICE

This Agreement made and entered into this 1<sup>st</sup> day of May, 2001, between FALL CREEK REGIONAL WASTE DISTRICT ("District") and Koran & Rebecca Skinner ("Applicant") regarding the provision of sanitary sewer service, and the assignment of capacity in, and connection to, the District's facilities for the premises located at 5778 Douglas Way.

NOW THEREFORE, the parties, in consideration of the mutual promises set out in this Agreement, the receipt and sufficiency of which is hereby acknowledged, agree as follows:

1. The Applicant agrees that all workmanship and materials shall conform to all District ordinances and the District's construction standards. District must accept and approve all work and materials before backfilling and final connection is made to the sewer mains. Any violation of this provision will cause all lines and appurtenances in violation to be removed and replaced at the Applicant's expense.
2. The District shall have the right to enter upon the Applicant's premises at all reasonable times to inspect, repair, or replace any equipment used in connection with the District's service or which has an impact on said service.
3. The Applicant shall be responsible for all monthly user rates, capacity charges, and tap fees. The failure to pay any rate charge or fee may result in a lien against the property and/or the termination of service to the property, the cost of which will be borne by Applicant, including, but not limited to, all attorney's fees and collection costs.
4. The District shall not be responsible for any damages as a result of any failure to supply service unless said damages are due to default, neglect or culpability on the part of the District.
5. If there is an available sanitary sewer within three hundred (300) feet of the property line, the property owner shall be required to connect to the District's sanitary sewer system.
6. The Applicant and District agree that the provision of sanitary sewer service touches and concerns the property and the terms of this Agreement bind the District and Applicant and their heirs, executors, administrators, personal representatives, successors, agents, attorneys, assigns, designees, and transferees.

The parties hereto have read and fully understand the above provisions and agree to comply with said provisions.

FALL CREEK REGIONAL WASTE DISTRICT

Jan Carey  
Signature

APPLICANT

Rebecca Skinner  
Signature

STATE OF INDIANA )  
                                  ) SS:  
COUNTY OF MADISON )

SUBSCRIBED and sworn to before me this 1<sup>st</sup> day of May, 2001.

My Commission Expires:

2-20-2008

Signature

Printed

Deborah L. Wilson  
Notary Public  
Resident of Madison County

\*\*\*\*\*  
INSPECTOR B DATE INSPECTED 5-22-01 APPROVED ✓ REJECTED \_\_\_\_\_

REASON FOR REJECTION \_\_\_\_\_

DATE REINSPECTED \_\_\_\_\_ APPROVED \_\_\_\_\_ REJECTED \_\_\_\_\_

NOTES:  
SIZE PIPE 6" TYPE PIPE 35"

BASEMENT YES NO X

SUMP PUMP YES NO X

DOWNSPOUT TO GROUND YES NO ✓


SEPTIC TANK PUMPED & FILLED YES NO X Curry's

CONTRACTOR Long & Koppa

SPECIAL CONDITIONS \_\_\_\_\_

EXISTING HOME X

NEW CONSTRUCTION \_\_\_\_\_

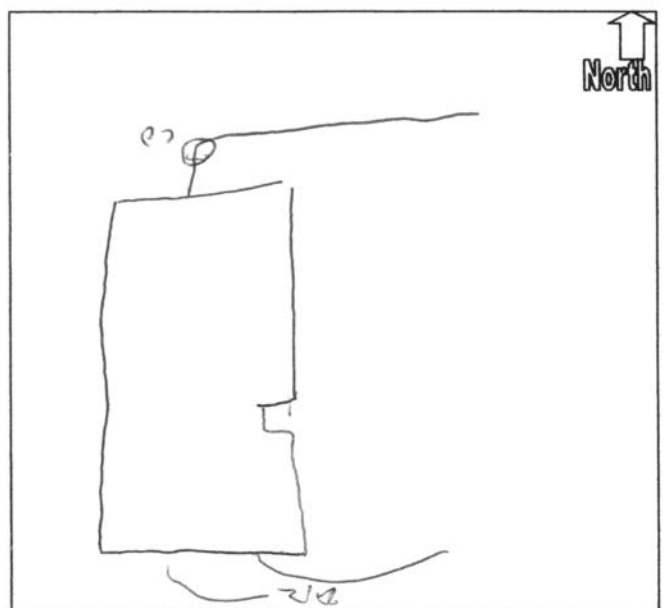



LORAN G. SKINNER  
REBECCA S. SKINNER

LIC. 8930-81-9749 8927-19-5417  
5778 DOUGLAS WAY PH. 765-778-3707  
ANDERSON, IN 46013

3140

20-7043/2740

DATE 5-1-01

Pay to the  
Order of

Ball Creek Regional Waste District \$ 2528.65

Two thousand five hundred twenty eight and 65/100

FIRST INDIANA BANK  
INDIANAPOLIS, INDIANA 46204

10-82  
50 FIRST

Sever Acc # 26-02530.00

Rebecca Skinner

⑆ 274070439⑆ 176001881⑆ 3140