

add order
on file
4433
26-02980.00

FALL CREEK REGIONAL WASTE DISTRICT

9378 S 650 WEST, P.O. BOX 59, PENDLETON, IN 46064
765-778-7544

AGREEMENT FOR SANITARY SEWER SERVICE

This Agreement made and entered into this 13th day of June, 2001, between FALL CREEK REGIONAL WASTE DISTRICT ("District") and Robert Yattaw ("Applicant") regarding the provision of sanitary sewer service, and the assignment of capacity in, and connection to, the District's facilities for the premises located at 5785 Houder Drive.

NOW THEREFORE, the parties, in consideration of the mutual promises set out in this Agreement, the receipt and sufficiency of which is hereby acknowledged, agree as follows:

1. The Applicant agrees that all workmanship and materials shall conform to all District ordinances and the District's construction standards. District must accept and approve all work and materials before backfilling and final connection is made to the sewer mains. Any violation of this provision will cause all lines and appurtenances in violation to be removed and replaced at the Applicant's expense.
2. The District shall have the right to enter upon the Applicant's premises at all reasonable times to inspect, repair, or replace any equipment used in connection with the District's service or which has an impact on said service.
3. The Applicant shall be responsible for all monthly user rates, capacity charges, and tap fees. The failure to pay any rate charge or fee may result in a lien against the property and/or the termination of service to the property, the cost of which will be borne by Applicant, including, but not limited to, all attorney's fees and collection costs.
4. The District shall not be responsible for any damages as a result of any failure to supply service unless said damages are due to default, neglect or culpability on the part of the District.
5. If there is an available sanitary sewer within three hundred (300) feet of the property line, the property owner shall be required to connect to the District's sanitary sewer system.
6. The Applicant and District agree that the provision of sanitary sewer service touches and concerns the property and the terms of this Agreement bind the District and Applicant and their heirs, executors, administrators, personal representatives, successors, agents, attorneys, assigns, designees, and transferees.

The parties hereto have read and fully understand the above provisions and agree to comply with said provisions.

FALL CREEK REGIONAL WASTE DISTRICT

APPLICANT

Signature _____

Signature _____

STATE OF INDIANA)
) SS:
COUNTY OF MADISON)

SUBSCRIBED and sworn to before me this _____ day of _____, 2001.

My Commission Expires: _____

Signature _____

Printed _____

Notary Public
Resident of Madison County

INSPECTOR B DATE INSPECTED 6-13-01 APPROVED ✓ REJECTED _____

REASON FOR REJECTION _____

DATE REINSPECTED _____ APPROVED _____ REJECTED _____

NOTES:
SIZE PIPE 6 TYPE PIPE 26

BASEMENT YES NO X

SUMP PUMP YES NO X

DOWNSPOUT TO GROUND YES X NO


SEPTIC TANK PUMPED & FILLED YES X NO Hydra

CONTRACTOR Kopper + Long

SPECIAL CONDITIONS _____

EXISTING HOME X

NEW CONSTRUCTION _____

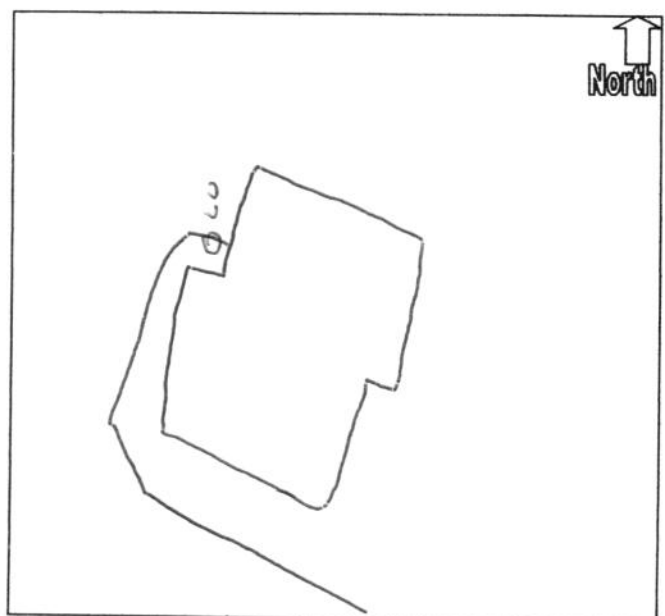



Rural Development

Rural Housing Service
1917 E. University Blvd.
Anderson, IN 46012-5103

Phone 765/644-4249
FAX 765/640-9029
TDD 317/290-3343

June 29, 2001

7644
Wanda Yattaw
5785 Hobbs Drive
Anderson, IN 46013

Dear Ms. Yattaw:

Enclosed please find check #1 payable to Fall Creek Regional Waste Water District to pay \$2,556.00 top and capacity fees for your sewer connection. You will need to sign and deliver to the Waste Water District.

You or the contractor should contact our office when work has been completed to schedule an inspection prior to payment.

If you have any questions or concerns please feel free to contact our office at the above address or telephone number.

Sincerely,

JUDY K. PRESLEY
Community Development Manager

JKP/rg

*Participating in the Success of Rural Indiana.
USDA, Rural Development is an Equal Opportunity Lender.
Complaints of Discrimination should be sent to:
USDA, Dir., Office of Civil Rights, Room 326-W, Whitten
Bldg., 1400 Independence Ave., SW, Washington, D.C.
20250-9410 or call (202) 720-5964.*

47
Pass Refor.
Signed ST
TR

End of st.
turn

NOT AS CO-MAKER OR ENDORSER

71-553/749

1

USDA - RURAL HOUSING SERVICE

DATE 6-28-01

© DELUXE WALLET OR DUPLICATE

Fall Creek Regional Waste Water Dist.

\$ 2556⁰⁰

PAY TO THE ORDER OF

Two thousand five hundred fifty six⁰⁰/₁₀₀

DOLLARS

Security features included. Details on back.



Madison Community Bank

MEMO

top & capacity fees

Wanda Yettan

MP

⑆074905539⑆ 104 531⑈

GENITY