

FALL CREEK REGIONAL WASTE DISTRICT

9378 S 650 WEST, P.O. BOX 59, PENDLETON, IN 46064  
765-778-7544

AGREEMENT FOR SANITARY SEWER SERVICE

This Agreement made and entered into this 27<sup>th</sup> day of April, 2001, between FALL CREEK REGIONAL WASTE DISTRICT ("District") and Derrick Smith ("Applicant") regarding the provision of sanitary sewer service, and the assignment of capacity in, and connection to, the District's facilities for the premises located at 5817 Douglas Way.

NOW THEREFORE, the parties, in consideration of the mutual promises set out in this Agreement, the receipt and sufficiency of which is hereby acknowledged, agree as follows:

1. The Applicant agrees that all workmanship and materials shall conform to all District ordinances and the District's construction standards. District must accept and approve all work and materials before backfilling and final connection is made to the sewer mains. Any violation of this provision will cause all lines and appurtenances in violation to be removed and replaced at the Applicant's expense.
2. The District shall have the right to enter upon the Applicant's premises at all reasonable times to inspect, repair, or replace any equipment used in connection with the District's service or which has an impact on said service.
3. The Applicant shall be responsible for all monthly user rates, capacity charges, and tap fees. The failure to pay any rate charge or fee may result in a lien against the property and/or the termination of service to the property, the cost of which will be borne by Applicant, including, but not limited to, all attorney's fees and collection costs.
4. The District shall not be responsible for any damages as a result of any failure to supply service unless said damages are due to default, neglect or culpability on the part of the District.
5. If there is an available sanitary sewer within three hundred (300) feet of the property line, the property owner shall be required to connect to the District's sanitary sewer system.
6. The Applicant and District agree that the provision of sanitary sewer service touches and concerns the property and the terms of this Agreement bind the District and Applicant and their heirs, executors, administrators, personal representatives, successors, agents, attorneys, assigns, designees, and transferees.

The parties hereto have read and fully understand the above provisions and agree to comply with said provisions.

FALL CREEK REGIONAL WASTE DISTRICT

Signature

APPLICANT

Signature

STATE OF INDIANA )  
 ) SS:  
COUNTY OF MADISON )

SUBSCRIBED and sworn to before me this 27<sup>th</sup> day of April, 2001.

My Commission Expires:

4-19-2008

Signature

Printed

Teresa K Hutton  
Notary Public  
Resident of Madison County

\*\*\*\*\*  
INSPECTOR B DATE INSPECTED 5-4-1 APPROVED ✓ REJECTED \_\_\_\_\_

REASON FOR REJECTION \_\_\_\_\_

DATE REINSPECTED \_\_\_\_\_ APPROVED \_\_\_\_\_ REJECTED \_\_\_\_\_

NOTES:

SIZE PIPE 6 TYPE PIPE 35

BASEMENT YES NO X

SUMP PUMP YES NO X

DOWNSPOUT TO GROUND YES X NO hard


SEPTIC TANK PUMPED & FILLED YES X NO

CONTRACTOR TEV

SPECIAL CONDITIONS \_\_\_\_\_

EXISTING HOME ✓

NEW CONSTRUCTION \_\_\_\_\_

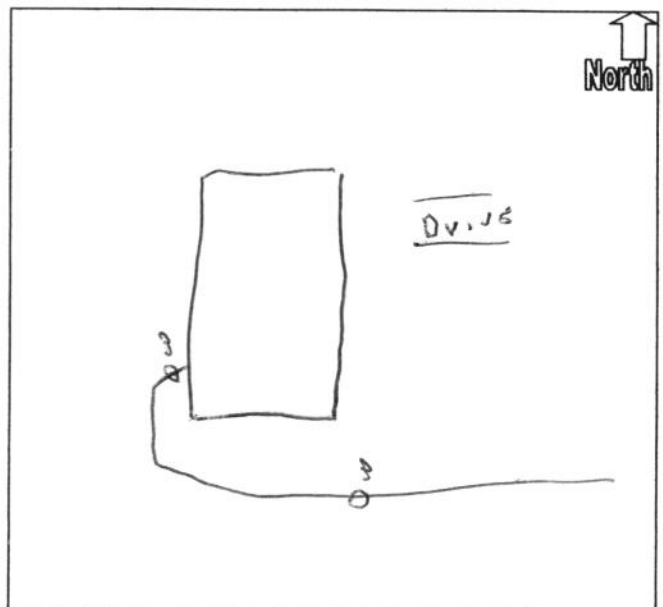

S

DERRICK SMITH 10-94  
RENEE SMITH  
PH. 765 778-3578  
5817 DOUGLAS WAY  
ANDERSON, IN 46013

20-7043/2740

3360

Date 4-27-01

Pay to the order of: FCRWD

\$400.00

Four Hundred and 00/100

dollars

Security Features  
Included.  
Details on Back

FIRST INDIANA BANK  
INDIANAPOLIS, INDIANA 46204

Memo

Renee Smith

MP

⑆274070439⑆ 170010276⑈ 3360

©CHECKS UNLIMITED™ • REFLECTIONS  
TO REDUCE: 1-800-394-2344 • www.ChecksUnlimited.com