

add order
on file
4295

26-02750.00

4295

This 24th day of April, 200 /
Joe Crouch ("Ap
ment of capacity in, and connection to the

at all reasonable times . . .
ce or which has an impact on safe

- The parties hereto have read and fully understand the above provisions and agree to comply with said provisions.

APPLICANT Crunch
Signature

SUBSCRIBED and sworn to before me this 24th day of April, 2001.

Signature Deborah L. Wilson
Printed Deborah L. Wilson
Notary Public
Resident of Madison County

REASON FOR REJECTION _____

NOTES:
SIZE PIPE 6" TYPE PIPE SOR 26

SUMP PUMP YES NO

DOWNSPOUT TO GROUND YES ☒ NO ☐


SEPTIC TANK PUMPED & FILLED YES NO

CONTRACTOR Ken Ray

SPECIAL CONDITIONS

EXISTING HOME ☒

NEW CONSTRUCTION

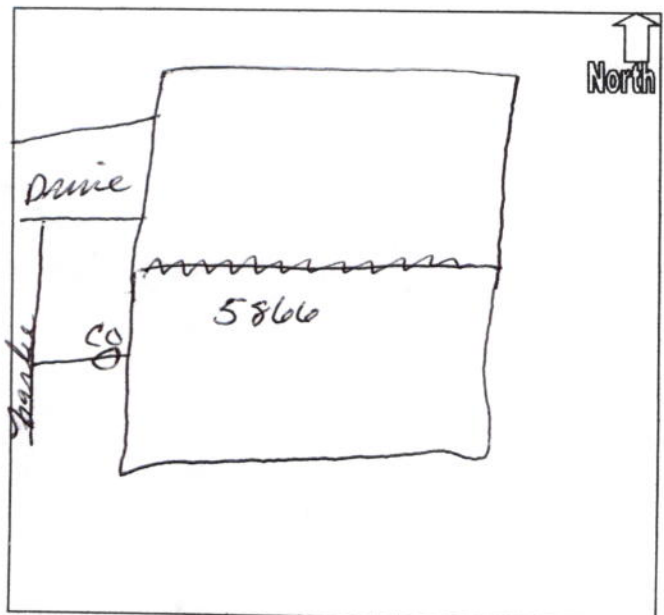



JOE CROUCH 1-81
BARBARA CROUCH
5866 FAIRLEE RD
ANDERSON, IN 46013-9736
PH 765-778-4515

5765

April 24 01 DATE

71-167/749
BRANCH 10006

PAY TO THE
ORDER OF

Fall Creek Regional Waste District

\$ 1872 ²⁵/₁₀₀

Eighteen hundred seventy two ²⁵/₁₀₀

DOLLARS



STAR
Financial Bank

FOR

Joe Crouch MP

⑆074901672⑆5765

⑈224 20194⑈

© HARLAND

