



# FALL CREEK REGIONAL WASTE DISTRICT

9378 S. 650 West PO Box 59  
Pendleton, IN 46064-0059 778-7544

21-03582.00

add order  
on file

Nº 2353

## APPLICATION FOR SEWER PERMIT

Date

4/4/96

Permit Void 90 days from Date of Issuance

Owner Name

Moore's Construction

Property Address

5939 W Reformatory Road

Lot #

P.O. Box

Town

Fortville

IN

Zip Code

46040

Phone

City Water

Well

✓

\$

400

Tap on Fee Paid

\$485

\$

2,000

capacity

inspection fee paid

5/14/97

Application is hereby made for connection to the Fall Creek Regional Waste District Sewer System for the above listed property - Permit Type: Residential ☒, Commercial ☐, Industrial ☐, or Governmental/Institutional ☐. User Information

All workmanship and materials shall conform to the standards of the District Ordinance as described in Ordinance 84-2 and 84-3 as amended. Acceptance and approval must be made by the District inspector or his duly authorized representative before backfilling and final connection is made to the main sewer lines. Any violation of applicable regulations will cause all lines and appurtenances in violation to be removed and replaced at the owners expense.

The Fall Creek Regional Waste District is responsible for the inspection, approval of materials, and installation techniques only. All costs for materials and installation and any liabilities resulting from same is the sole responsibility of the property owner.

I have read and fully understand the above provisions and agree to comply by said provisions.

Nathan Moore

APPLICANT(S) SIGNATURE

INSPECTOR

Tim

Date inspected

4-8-96

Approved

✓

Rejected

Reason for rejection

Date reinspected

Approved

Rejected

Notes:

Size Pipe

4"

Type Pipe

sch. 40

Basement Yes

No

Sump Pump Yes

No

Downspout to Ground Yes

No

Septic Tank Pumped & filled Yes

No

Contractor


SELF

Special Conditions

Existing Home

New Construction

✓

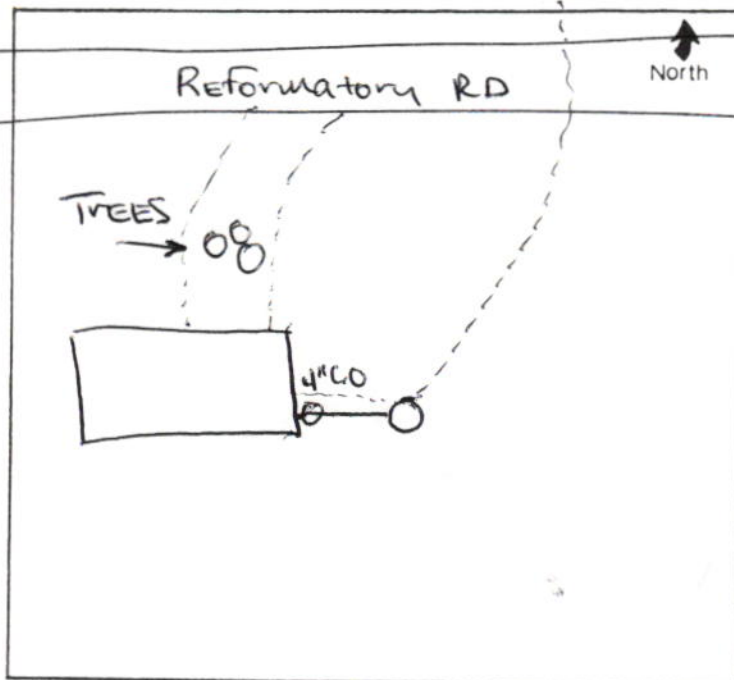

MOORE'S CONSTRUCTION CO 4-91  
NATHAN OR PHYLLIS MOORE  
5939 W REFORMATORY RD (317) 778-3573  
FORTVILLE, IN 46040-9027

4061

71-167/749  
BRANCH 10001

May 14 1997

Pay to  
the order of

F. E. R. W. D.

\$200000

Two thousand and no

Dollars  Security features  
included.  
Details on back.



**STAR**  
**FINANCIAL**  
**BANK**

Anderson • Ellettsville  
Perrin • Tipton  
Carmel • Indianapolis, Indiana

For

Nathan Moore

MP

⑆074901672⑆ 4061⑈