

21-03586.00

add order  
on file

## FALL CREEK REGIONAL WASTE DISTRICT

9378 S. 650 West PO Box 59  
Pendleton, IN 46064-0059 778-7544

No 2383

## APPLICATION FOR SEWER PERMIT

Date

6/18/96

Permit Void 90 days from Date of Issuance

Owner Name

Michael Brown

Blake Home

Property Address

5961 W. Reformatory Road

Lot #

P.O. Box

Town Fortville

IN

Zip Code

46040

Phone

City Water

Well

✓

\$

700

Tap on Fee Paid

9/9/98

\$

2185

Inspection fee paid

9/9/98

Application is hereby made for connection to the Fall Creek Regional Waste District Sewer System for the above listed property - Permit Type: Residential ☒, Commercial ☐, Industrial ☐, or Governmental/Institutional ☐. User Information \_\_\_\_\_.

All workmanship and materials shall conform to the standards of the District Ordinance as described in Ordinance 84-2 and 84-3 as amended. Acceptance and approval must be made by the District inspector or his duly authorized representative before backfilling and final connection is made to the main sewer lines. Any violation of applicable regulations will cause all lines and appurtenances in violation to be removed and replaced at the owners expense.

The Fall Creek Regional Waste District is responsible for the inspection, approval of materials, and installation techniques only. All costs for materials and installation and any liabilities resulting from same is the sole responsibility of the property owner.

I have read and fully understand the above provisions and agree to comply by said provisions.

APPLICANT(S) SIGNATURE

INSPECTOR

Tim

Date inspected

6-18-96

Approved

Rejected

Reason for rejection

Date reinspected

Approved

Rejected

Notes:

Size Pipe

4"

Type Pipe

SCH. 40

Basement Yes

No

Sump Pump Yes

No

Downspout to Ground Yes

No

Septic Tank Pumped &amp; filled Yes

No

Contractor

Mike Blake / Bob Ford


Special Conditions

(Zoller Pump)

Existing Home

New Construction

✓

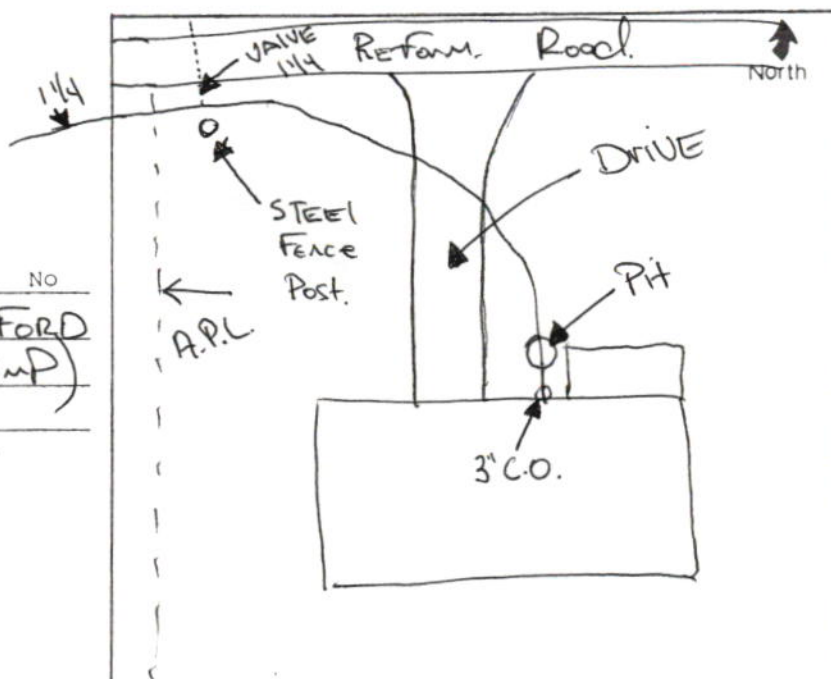

DOCUMENT NO. 1 TO RECORDER 1 800 324 3244 MARKED PAY

B

MICHAEL J. BROWN  
NICOLE T. BROWN  
PH. 778-1730  
5961 W. REFORMATORY RD.  
FORTVILLE, IN 46040

20-7043/2740

2020

Date 9-1-98

PAY

to the order of Jail Creek Reg. Waste

\$2185<sup>00</sup>/<sub>100</sub>

Two thousand one hundred eighty five <sup>00</sup>/<sub>100</sub> Dollars

Security Features  
Included  
Details on back.

FIRST INDIANA BANK  
INDIANAPOLIS, INDIANA 46204

4-95

For Sewer fees

Nicole T. Brown

MP

⑆274070439⑆

2020

DOCUMENT NO. 1 TO RECORDER 1 800 324 3244 MARKED PAY

B

MICHAEL J. BROWN  
NICOLE T. BROWN  
PH. 778-1730  
5961 W. REFORMATORY RD.  
FORTVILLE, IN 46040

20-7043/2740

2035

Date 9-7-98

PAY

to the order of Jail Creek Regional Waste Dist

\$700<sup>00</sup>/<sub>100</sub>

Seven hundred <sup>00</sup>/<sub>100</sub> Dollars

Security Features  
Included  
Details on back.

FIRST INDIANA BANK  
INDIANAPOLIS, INDIANA 46204

4-95

For

Nicole T. Brown

MP

⑆274070439⑆

2035