



FALL CREEK REGIONAL WASTE DISTRICT

9378 S. 650 West PO Box 59  
Pendleton, IN 46064-0059 778-7544

add order  
on file

26-00320.00

Nº 2795

APPLICATION FOR SEWER PERMIT

Date 6/5/00

Permit Void 90 days from Date of Issuance

Owner Name Pete Hosier

Property Address 5982 WSR 38

Lot # \_\_\_\_\_ P.O. Box \_\_\_\_\_

Town Pendleton, IN Zip Code 46064

Phone \_\_\_\_\_ City Water \_\_\_\_\_ Well ☒

\$ 2556.00 Tap on Fee Paid \$1024.80 grinder unit

\$ \_\_\_\_\_ Inspection fee paid

Application is hereby made for connection to the Fall Creek Regional Waste District Sewer System for the above listed property - Permit Type: Residential ☒, Commercial \_\_\_\_\_, Industrial \_\_\_\_\_, or Governmental/Institutional \_\_\_\_\_. User Information \_\_\_\_\_.

All workmanship and materials shall conform to the standards of the District Ordinance as described in Ordinance 84-2 and 84-3 as amended. Acceptance and approval must be made by the District inspector or his duly authorized representative before backfilling and final connection is made to the main sewer lines. Any violation of applicable regulations will cause all lines and appurtenances in violation to be removed and replaced at the owners expense.

The Fall Creek Regional Waste District is responsible for the inspection, approval of materials, and installation techniques only. All costs for materials and installation and any liabilities resulting from same is the sole responsibility of the property owner.

I have read and fully understand the above provisions and agree to comply by said provisions.

APPLICANT(S) SIGNATURE

INSPECTOR DW

Date inspected 7-6-00 Approved ☒ Rejected \_\_\_\_\_

Reason for rejection \_\_\_\_\_

Date reinspected \_\_\_\_\_ Approved \_\_\_\_\_ Rejected \_\_\_\_\_

Notes: Size Pipe 1 1/2" FM / 4" LAF

Type Pipe PVC

Basement Yes \_\_\_\_\_ No ☒

Sump Pump Yes \_\_\_\_\_ No ☒

Downspout to Ground Yes ☒ No \_\_\_\_\_


Septic Tank Pumped & filled Yes \_\_\_\_\_ No NO TANK

Contractor LONG / KOTHE EXC.

Special Conditions \_\_\_\_\_

Existing Home ☒

New Construction \_\_\_\_\_

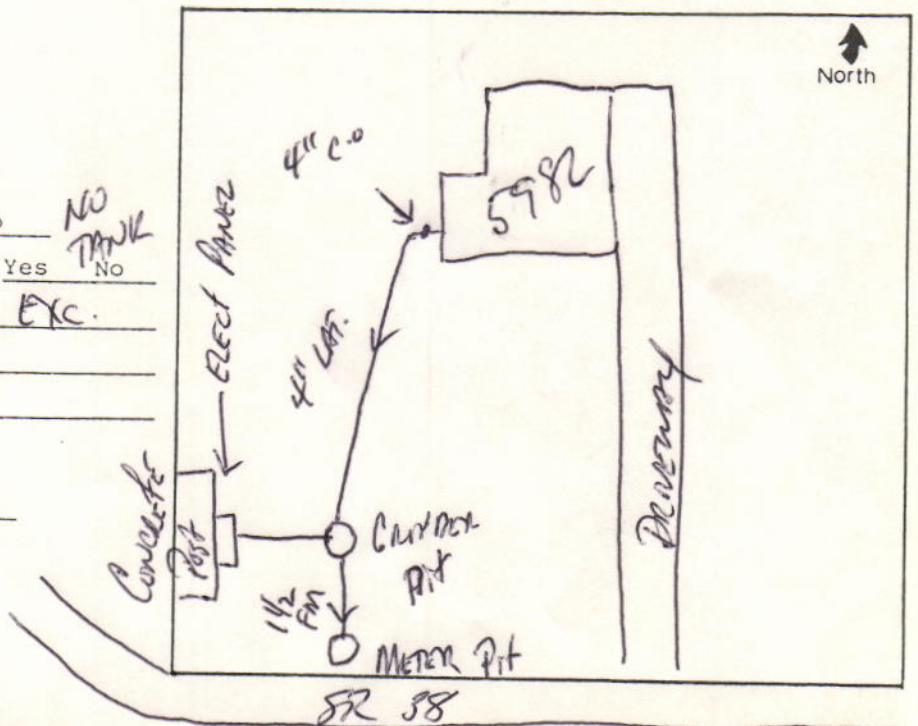

9378 S. CR 650 W.  
P.O. Box 59  
Pendleton, IN 46064  
Phone: 765-778-7544

**INVOICE**

Name	Pete Hosier	Acct #	26-00320.00
Address	5982 W SR 38		
City	Pendleton	State	IN Zip 46064
Phone			

QTY	DESCRIPTION	UNIT PRICE	TOTAL
1	tap fee	\$400.00	\$400.00
1	capacity fee	\$2,156.00	\$2,156.00
1	grinder unit	\$1024.80	\$1024.80
		Sub-Total	<del>\$2,556.00</del>

DATE	PAYMENT	CHECK NUMBER	AMOUNT
			\$0.00
		Sub-Total	\$0.00

\$3580.80

**Cut here**

Name	Pete Hosier	Acct #	26-00320.00
Address	5982 W SR 38		
City	Pendleton	State	IN Zip 46064
Phone	0		

Project Area # D  
W.O. # 9915  
Due Date 90 days

\$3580.80

## DAILY SUMMARY

CMD7-END

Account No 260032000 HOSIER, PETE

5982 W SR 38

Sel	Date	Tran Type	Total	Waste	Wtr	Penalty
	3/25/99	BILLING	27.35	27.35		
	4/26/99	BILLING	54.70	54.70		
	5/19/99	BILL ADJ	.41	.41		
	5/26/99	BILLING	82.05	82.05		
	6/25/99	BILLING	109.40	109.40		
	7/26/99	BILLING	136.75	136.75		
	8/27/99	BILLING	164.10	164.10		
	9/24/99	BILLING	191.45	191.45		
	10/25/99	BILLING	218.80	218.80		
	11/24/99	BILLING	246.15	246.15		
	12/23/99	BILLING	273.50	273.50		
	1/24/00	BILLING	300.85	300.85		
	2/17/00	BILL ADJ	4.10	4.10		
	2/25/00	BILLING	328.20	328.20		
	3/24/00	BILLING	355.55	355.55		

*Yd c*