



FALL CREEK REGIONAL WASTE DISTRICT

12-04470.00

Box 44, Pendleton, Indiana 46064

2-0004470.00

Nº 001756

APPLICATION FOR SEWER PERMIT

Permit No. _____ Date 8-31-90

Permit Void 90 days from Date of Issuance

Owner Name Wile, HowardProperty Address RR 4 Box 242 5996 S. 100 West

Lot # _____ P.O. Box _____

Town _____, IN Zip Code _____

Phone _____ Water Meter _____"

\$ _____ Tap on Fee Paid

\$ _____ Inspection fee paid

Application is hereby made for connection to the Fall Creek Regional Waste District Sewer System for the above listed property - Permit Type: Residential X, Commercial _____, Industrial _____, or Governmental/Institutional _____. User Information _____.

All workmanship and materials shall conform to the standards of the District Ordinance as described in Ordinance 84-2 and 84-3 as amended. Acceptance and approval must be made by the District inspector or his duly authorized representative before backfilling and final connection is made to the main sewer lines. Any violation of applicable regulations will cause all lines and appurtenances in violation to be removed and replaced at the owners expense.

The Fall Creek Regional Waste District is responsible for the inspection, approval of materials, and installation techniques only. All costs for materials and installation and any liabilities resulting from same is the sole responsibility of the property owner.

I have read and fully understand the above provisions and agree to comply by said provisions.

APPLICANT(S) SIGNATURE _____

INSPECTOR BDate inspected 8-31-90 Approved ✓ Rejected _____


Reason for rejection _____

Date reinspected _____ Approved _____ Rejected _____

Notes:

Size Pipe 6 "Type Pipe PVCBasement Yes X No ✓Sump Pump Yes _____ No XDownspout to Ground Yes ✓ No _____Septic Tank Pumped & filled Yes ✓ No _____Contractor EARL DAVIS

Special Conditions _____

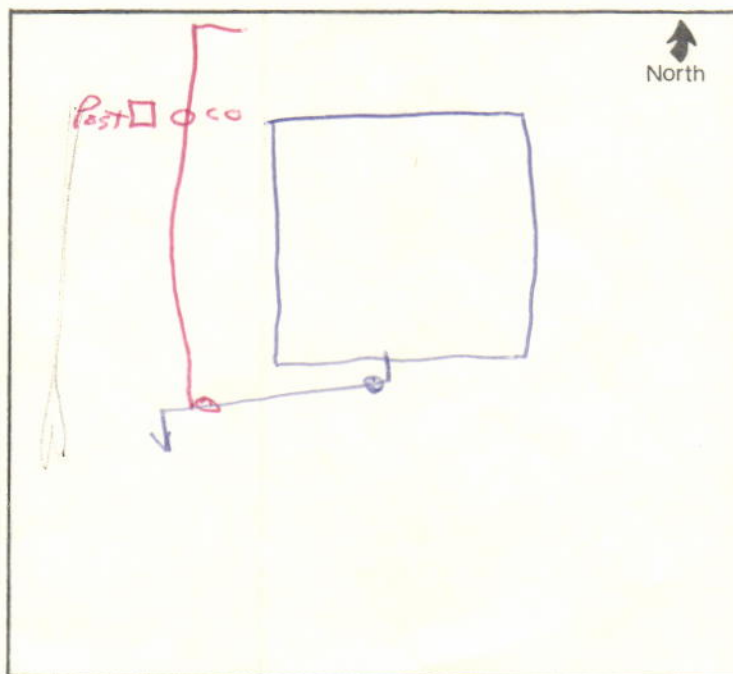

T.
WILE TAP FEE?

9-5-90

WAS THIS AN ARRANGEMENT
OF R/W NEGOTIATIONS?

(I THINK IT WAS)

Joe

RAVETT NO ARRANGEMENTS



FALL CREEK REGIONAL WASTE DISTRICT

P.O. Box 59 • 9378 S. 650 West • Pendleton, Indiana 46064-0059 • (317) 778-3983

October 23, 1990

Howard Wile
RR #4 Box 242
Pendleton, IN 46064

RE: Tap & Insp. Fee

Dear Mr. Wile:

At the time of your connection into the District wastewater system, August 31, 1990, the tap & inspection fees were not paid.

It was reported to the District at that time that the original right-of-way negotiations included a tap fee. A check of District R/W records and verification with the District Attorney show a R/W fee paid to the original land owner Faucett. No tap fee negotiation was included in the transaction.

The minimum residential tap fee is \$500.00 plus a \$25.00 inspection and admin. fee.

Unless evidence of a paid up tap fee can be provided, the cost of your tap is \$525.00. Please consider this letter as a claim in this amount.

If you wish to discuss this further, please contact this office at (317) 778-3983.

Respectfully,

Dod Nobel
General Manager

tas