

Gidw.


PROJECT Phase II SHEET _____ OF _____

SUBJECT _____ DATE 4-11-18

JOB NO. 4447

BY Atlas

600 W. High

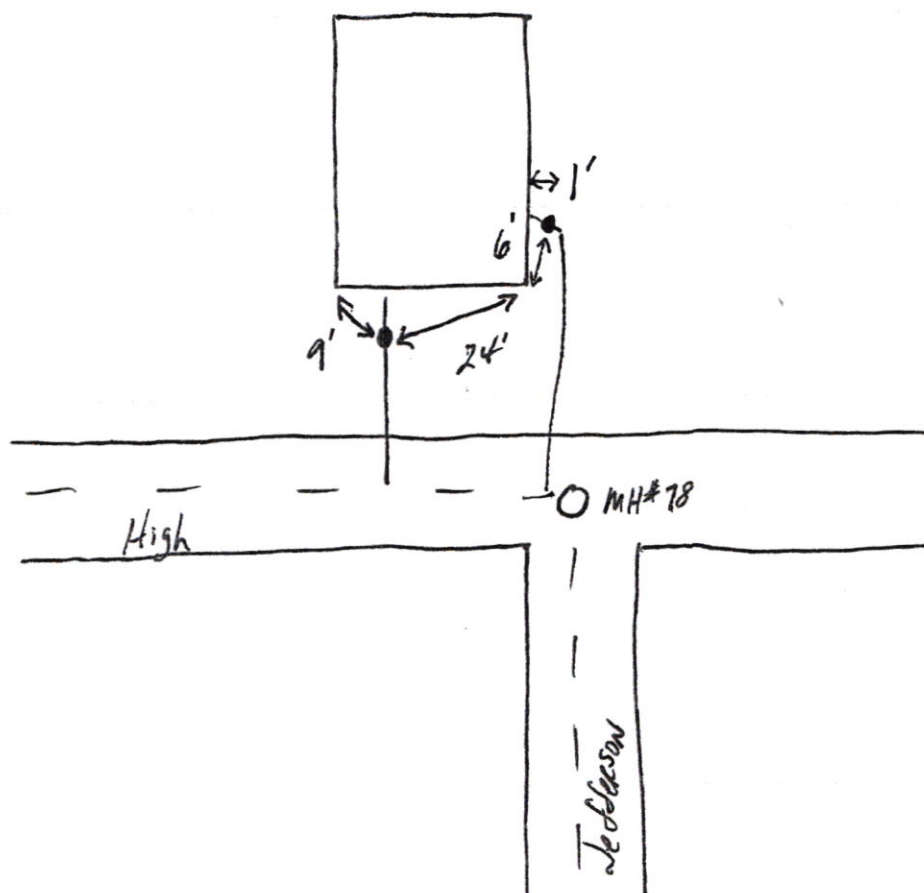

Gidw.


PROJECT Phase II SHEET _____ OF _____

SUBJECT _____ DATE 4-11-18

JOB NO 4447

BY Atlas

600 W. High

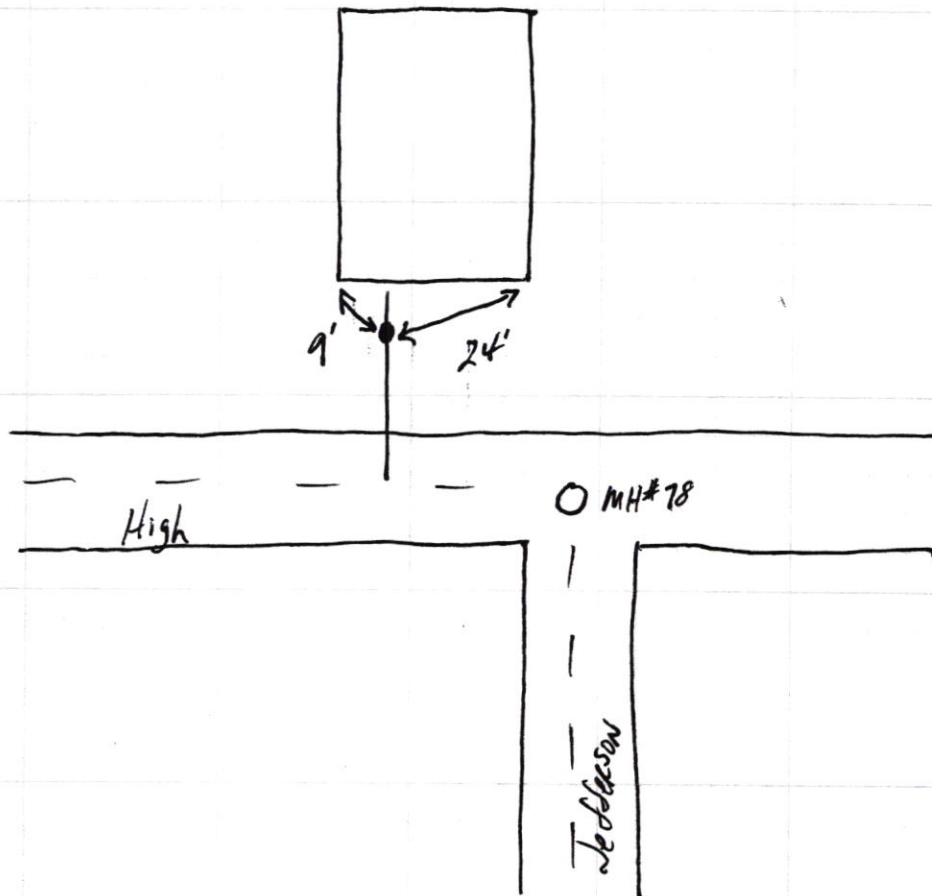

Low w High

SRP
Phase II

4.20.18



600 W High

SRP
Phase II

4.20.18

