

Gidw.


PROJECT Phase II SHEET _____ OF _____

SUBJECT _____ DATE 4-26-18

JOB NO. 4447

BY At/as

601 S. BROADWAY

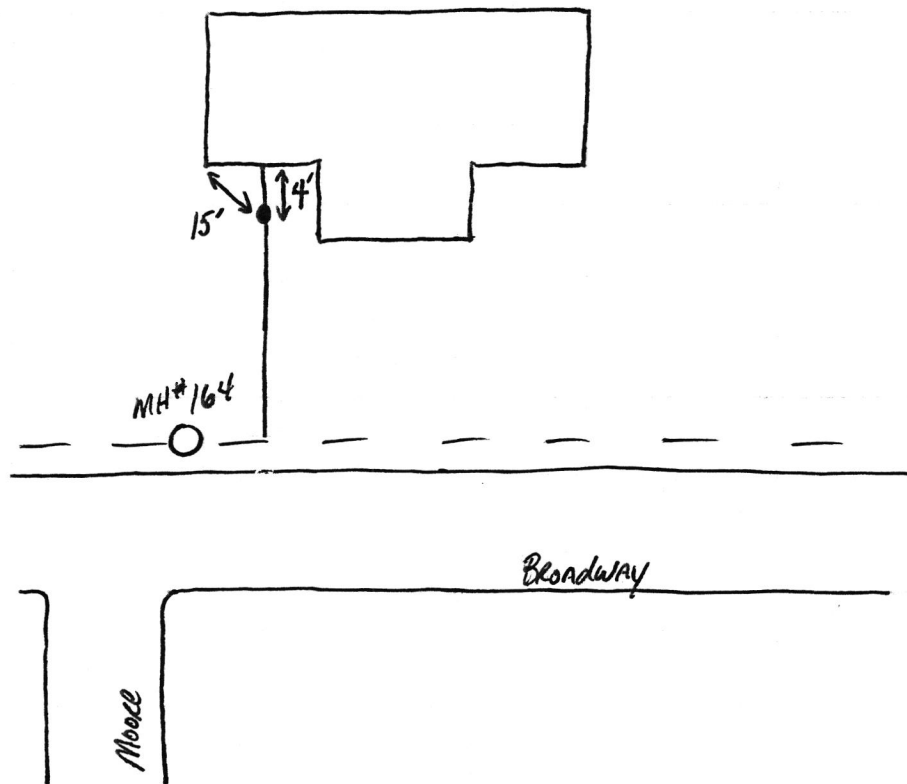

601 S Broadway

SRP
Phase II

5-3-18

