

Gidw.

PROJECT Phase II SHEET _____ OF _____


SUBJECT _____ DATE 6-15-18

JOB NO. 4467

BY Atlas

601 S. Pendleton

← N

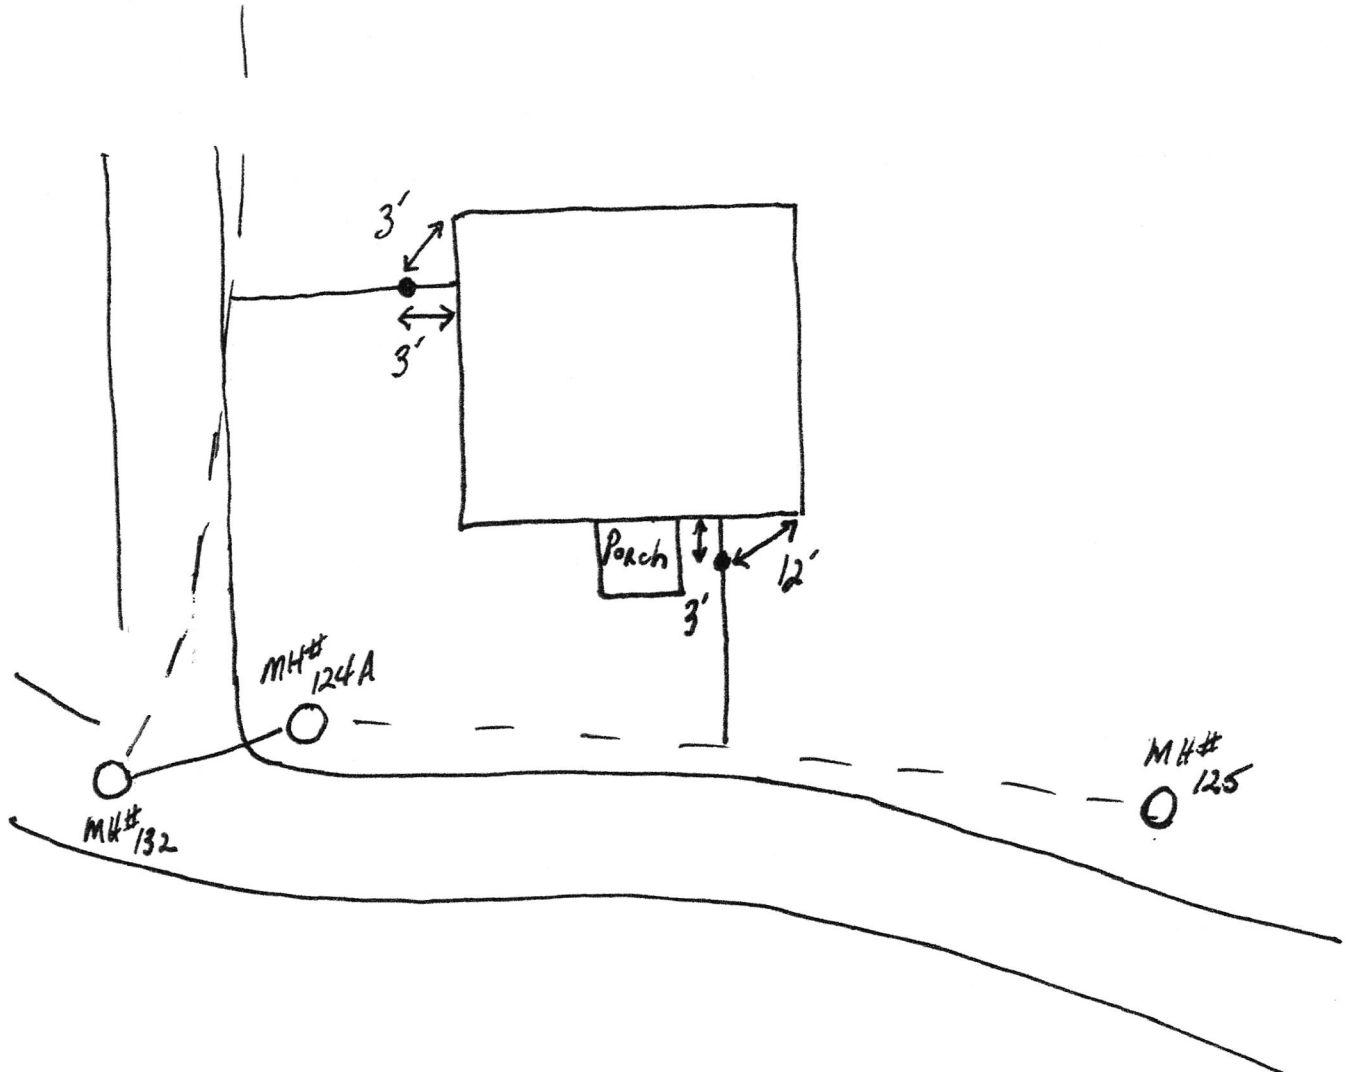

renovation

SPT Phase II

8/21/18



W01 > renovation H06

SRF Phase II

6.19.18

