

Gidw.


PROJECT Phase II SHEET _____ OF _____

SUBJECT _____ DATE 4-13-18

JOB NO. 4447

BY Atlas

601 ~~Mitt Rd~~
w State ST

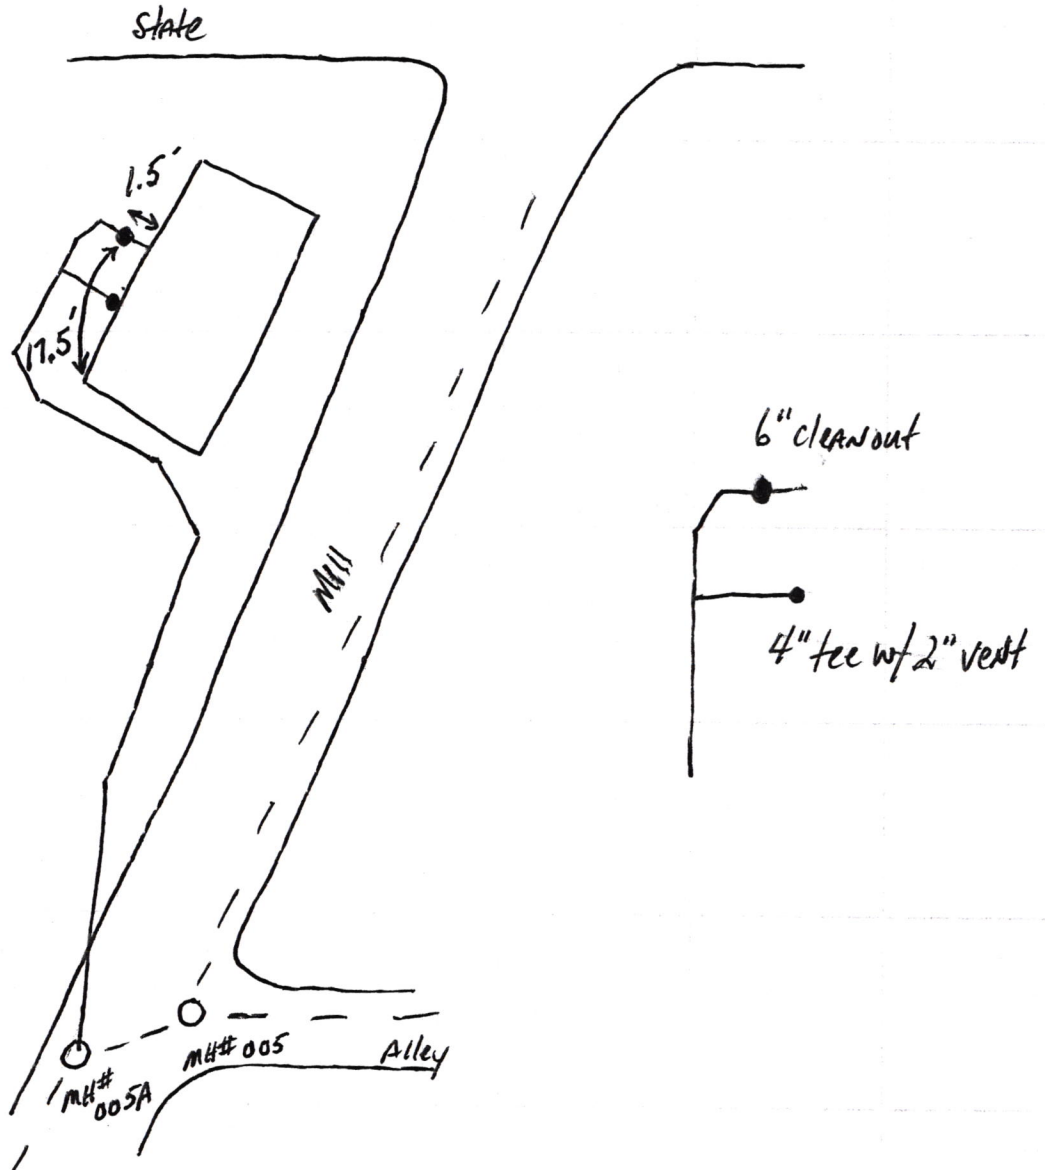



4.30.18

SHP
Phase II

Lot 111
W State ST