

Gidw.


PROJECT Phase II SHEET _____ OF _____

SUBJECT _____ DATE 3-2-18

JOB NO. 4447

BY Atlas

601 W. Taylor

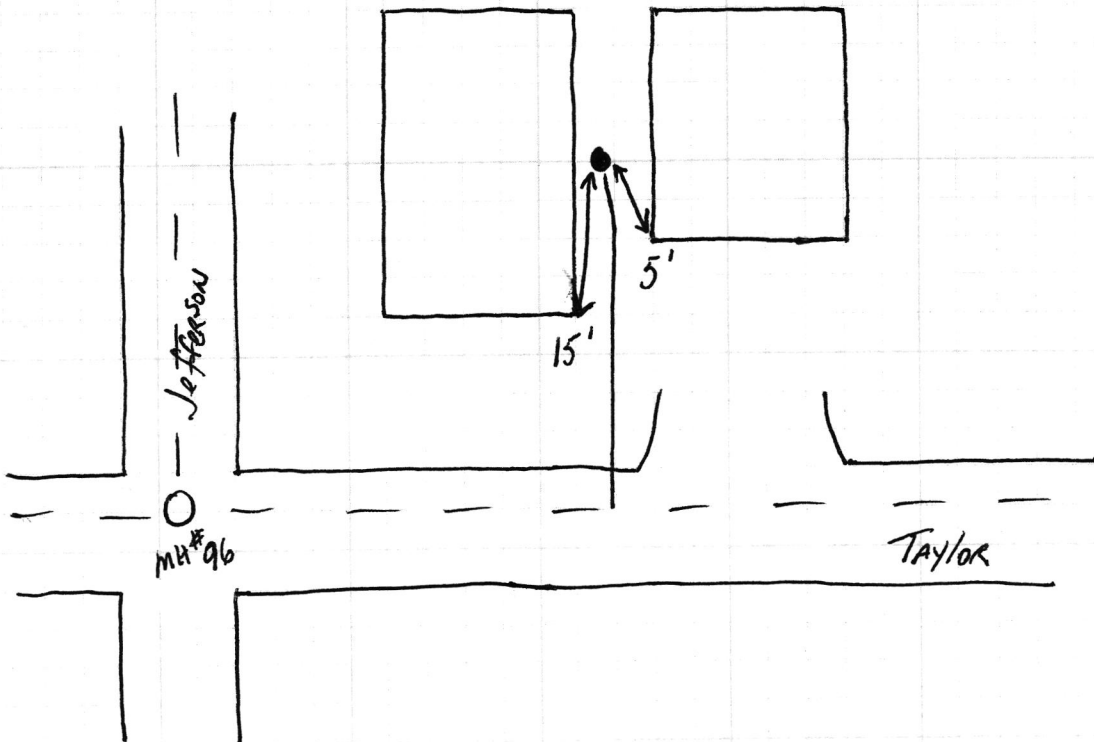

601 W Taylor

SRP Phase II

