



# FALL CREEK REGIONAL WASTE DISTRICT

9378 S. 650 West PO Box 59  
Pendleton, IN 46064-0059 778-7544 13-30828.00

add order  
on file

## APPLICATION FOR SEWER PERMIT

No 2382

Date 6/11/96

Permit Void 90 days from Date of Issuance

Owner Name Mustin Builders, Inc. Kevin Smith

Property Address 602 Buck Lane

Lot # 12 Deerfield P.O. Box \_\_\_\_\_

Town Pendleton, IN Zip Code 46064

Phone \_\_\_\_\_ City Water ☒ Well \_\_\_\_\_

\$ 500.00 Tap on Fee Paid

\$ N/A Inspection fee paid

Application is hereby made for connection to the Fall Creek Regional Waste District Sewer System for the above listed property - Permit Type: Residential ☒, Commercial \_\_\_\_\_, Industrial \_\_\_\_\_, or Governmental/Institutional \_\_\_\_\_. User Information \_\_\_\_\_.

All workmanship and materials shall conform to the standards of the District Ordinance as described in Ordinance 84-2 and 84-3 as amended. Acceptance and approval must be made by the District inspector or his duly authorized representative before backfilling and final connection is made to the main sewer lines. Any violation of applicable regulations will cause all lines and appurtenances in violation to be removed and replaced at the owners expense.

The Fall Creek Regional Waste District is responsible for the inspection, approval of materials, and installation techniques only. All costs for materials and installation and any liabilities resulting from same is the sole responsibility of the property owner.

I have read and fully understand the above provisions and agree to comply by said provisions.

Steve Mustin, President  
APPLICANT(S) SIGNATURE

INSPECTOR [Signature]

Date inspected 6-11-96 Approved ☒ Rejected \_\_\_\_\_

Reason for rejection \_\_\_\_\_

Date reinspected \_\_\_\_\_ Approved \_\_\_\_\_ Rejected \_\_\_\_\_

### Notes:

Size Pipe 6"

Type Pipe PVC

Basement Yes \_\_\_\_\_ No ☒

Sump Pump Yes \_\_\_\_\_ No ☒

Downspout to Ground Yes ☒ No \_\_\_\_\_


Septic Tank Pumped & filled Yes \_\_\_\_\_ No ☒

Contractor Smith

Special Conditions \_\_\_\_\_

Existing Home \_\_\_\_\_

New Construction ☒

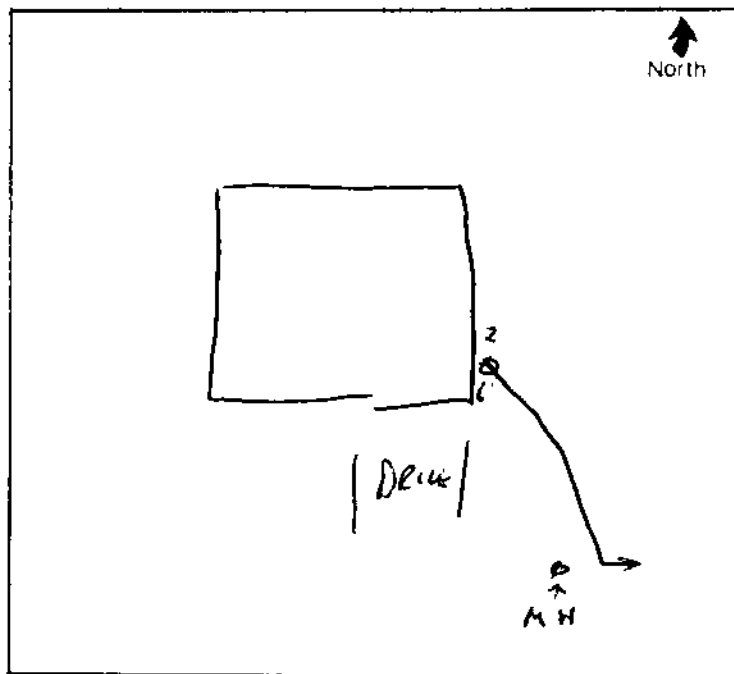

TO Mustin Builders, Inc.

810 Central Avenue

Anderson, IN 46012

SUBJECT

Permit for Lot 12 - Deerfield Addition - Pendleton

DATE

6/12/96

MESSAGE

Enclosed is the sewer permit for lot 12 in Deerfield Addition in Pendleton. Please sign the permit, keep the pink ~~and~~ and return the other two copies with the tap fee of \$500.

Thank You,

SIGNED

Debbie Wilson

DATE

REPLY

SIGNED



**MUSTIN BUILDERS, INC.**

810 CENTRAL AVENUE  
ANDERSON, IN 46012  
PH. 317-644-8502

**SOCIETY NATIONAL BANK**  
ANDERSON, IN 46015  
6-704-412

27728

Pay: Five hundred dollars and no cents

DATE  
June 21, 1996

CHECK NO. AMOUNT  
27728 \$\*\*\*\*\*500.00\*\*

PAY  
TO THE  
ORDER  
OF

FALL CREEK WASTE MGMT.  
P. O. Box 59  
County Road 650 West  
Pendleton, IN 46064

⑈027728⑈