



FALL CREEK REGIONAL WASTE DISTRICT

9378 S. 650 West PO Box 59
Pendleton, IN 46064-0059 778-7544

22-27106.00

Nº 2179

APPLICATION FOR SEWER PERMIT

Date 2-24-95

Permit Void 90 days from Date of Issuance

Owner Name Harvey, Steve Bruce ? It is Bruce

Property Address 6032 Red Fox 6032 Woodchuck

Lot # 70 - HHE Sec. III P.O. Box _____

Town Pendleton, IN Zip Code 46064

Phone _____ City Water _____ Well ☒

\$ 700.00 Tap on Fee Paid

\$ 25.00 Inspection fee paid

well rec # 4726

Application is hereby made for connection to the Fall Creek Regional Waste District Sewer System for the above listed property - Permit Type: Residential ☒, Commercial _____, Industrial _____, or Governmental/Institutional _____. User Information _____.

All workmanship and materials shall conform to the standards of the District Ordinance as described in Ordinance 84-2 and 84-3 as amended. Acceptance and approval must be made by the District inspector or his duly authorized representative before backfilling and final connection is made to the main sewer lines. Any violation of applicable regulations will cause all lines and appurtenances in violation to be removed and replaced at the owners expense.

The Fall Creek Regional Waste District is responsible for the inspection, approval of materials, and installation techniques only. All costs for materials and installation and any liabilities resulting from same is the sole responsibility of the property owner.

I have read and fully understand the above provisions and agree to comply by said provisions.

APPLICANT(S) SIGNATURE

INSPECTOR DN

Date inspected 2/24/95 Approved ☒ Rejected _____

Reason for rejection _____

Date reinspected _____ Approved _____ Rejected _____

Notes:

Size Pipe 6"

Type Pipe PVC

Basement Yes ☒ No _____

Sump Pump Yes _____ No ☒

Downspout to Ground Yes ☒ No _____


Septic Tank Pumped & filled Yes NR No _____

Contractor Bolton Const.

Special Conditions _____

Existing Home _____

New Construction ☒

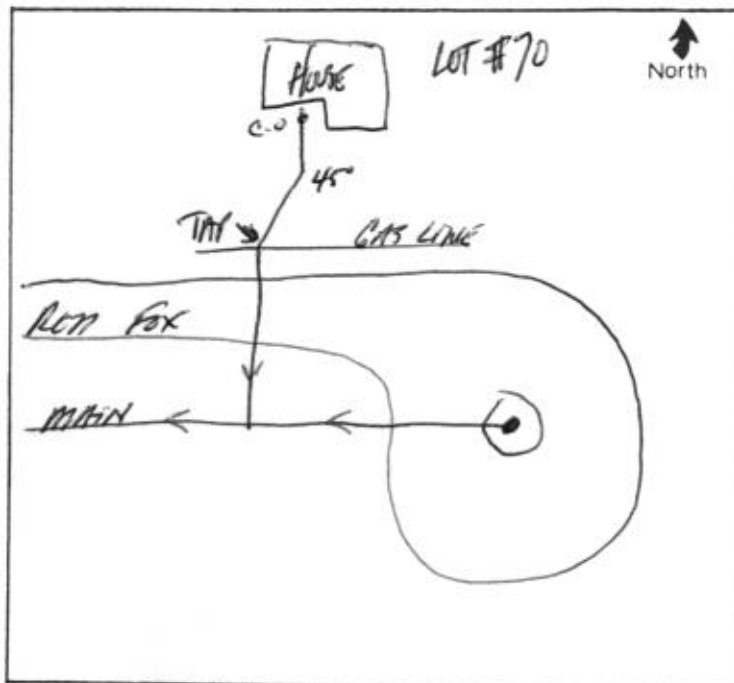



FALL CREEK REGIONAL WASTE DISTRICT

9378 S. 650 West PO Box 59
Pendleton, IN 46064-0059 778-7544

add order
on file

APPLICATION FOR SEWER PERMIT

Nº 2167

Date 12/16/94

Permit Void 90 days from Date of Issuance

Owner Name

Steve Hardy

Niccum

Property Address

Red Fox Road

Lot #

70 - SHAE Sec 3

P.O. Box

Town

Pendleton

, IN

Zip Code

46064

Phone

City Water

Well ☒

\$ 700.00

Tap on Fee Paid

\$ 25.00

Inspection fee paid

Rec # 4726

Application is hereby made for connection to the Fall Creek Regional Waste District Sewer System for the above listed property - Permit Type: Residential ☒, Commercial ☐, Industrial ☐, or Governmental/Institutional ☐. User Information _____

All workmanship and materials shall conform to the standards of the District Ordinance as described in Ordinance 84-2 and 84-3 as amended. Acceptance and approval must be made by the District inspector or his duly authorized representative before backfilling and final connection is made to the main sewer lines. Any violation of applicable regulations will cause all lines and appurtenances in violation to be removed and replaced at the owners expense.

The Fall Creek Regional Waste District is responsible for the inspection, approval of materials, and installation techniques only. All costs for materials and installation and any liabilities resulting from same is the sole responsibility of the property owner.

I have read and fully understand the above provisions and agree to comply by said provisions.

APPLICANT(S) SIGNATURE

INSPECTOR

[Signature]

Date inspected

Approved ☒

Rejected ☐

Reason for rejection _____

Date reinspected

Approved

Rejected

Notes:

Size Pipe

6"

Type Pipe

AC

Basement Yes

No ☒

Sump Pump Yes

No ☒

Downspout to Ground Yes

No

Septic Tank Pumped & filled Yes

No

Contractor

Baker

Special Conditions _____

Existing Home

New Construction ☒

