



# FALL CREEK REGIONAL WASTE DISTRICT

9378 S. 650 West PO Box 59  
Pendleton, IN 46064-0059 778-7544

add order  
on file

22-27116.00

## APPLICATION FOR SEWER PERMIT

Nº 2704

Date

Sept 14, 1999

Permit Void 90 days from Date of Issuance

Owner Name

Curt J & Rebecca Gassmann/RGB Builders

Property Address

6037 S. Red Fox Road

Lot #

65, HHE

P.O. Box

Town

Pendleton

IN

Zip Code

46064

Phone

778-8443

City Water

Well X

\$

400<sup>00</sup>

Tap on Fee Paid

\$

Inspection fee paid

Application is hereby made for connection to the Fall Creek Regional Waste District Sewer System for the above listed property - Permit Type: Residential ☒, Commercial ☐, Industrial ☐, or Governmental/Institutional ☐. User Information

All workmanship and materials shall conform to the standards of the District Ordinance as described in Ordinance 84-2 and 84-3 as amended. Acceptance and approval must be made by the District inspector or his duly authorized representative before backfilling and final connection is made to the main sewer lines. Any violation of applicable regulations will cause all lines and appurtenances in violation to be removed and replaced at the owners expense.

The Fall Creek Regional Waste District is responsible for the inspection, approval of materials, and installation techniques only. All costs for materials and installation and any liabilities resulting from same is the sole responsibility of the property owner.

I have read and fully understand the above provisions and agree to comply by said provisions.

Rebecca Gassmann

APPLICANT(S) SIGNATURE

INSPECTOR

B

Date inspected

12/30/99

Approved

V

Rejected

Reason for rejection

Date reinspected

Approved

Rejected

Notes:

Size Pipe

6

Type Pipe

PVC

Basement

Yes

X

No

Sump Pump

Yes

X

No

Downspout to Ground

Yes

X

No

Septic Tank Pumped & filled

Yes

No

X

Contractor


Royal Flush

Special Conditions

Existing Home

New Construction

X

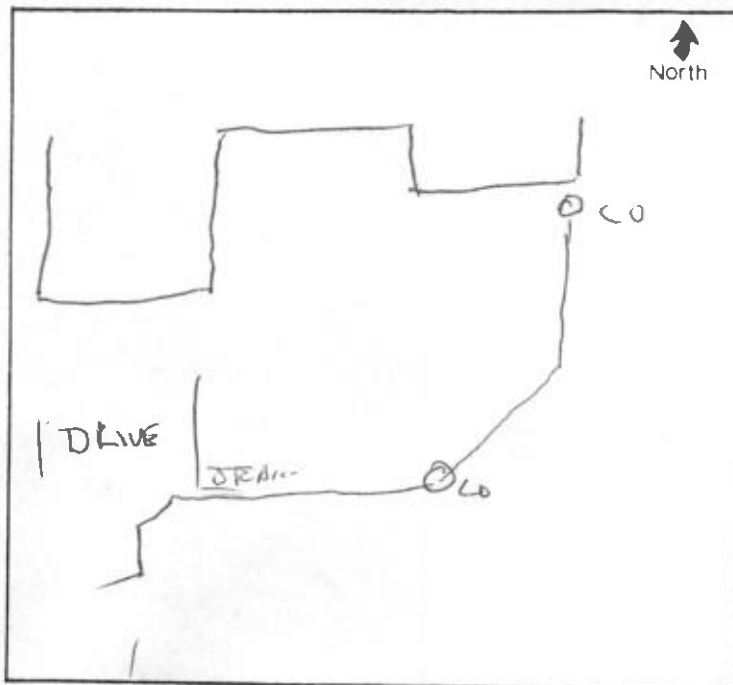

DATA FROM  
FIELD

FALL CREEK REGIONAL WASTE DISTRICT

3150 S. 25th Street, PO Box 10  
Burlington, IN 46601-0010 317-334-1111



88-2111-00

IN 3704

ATTENTION: FALL CREEK REGIONAL WASTE DISTRICT

DATE: Sept 14, 1999

Owner Name: Curt & Patricia Gossman, Reg. Fall Creek  
Property Address: 10012 1/2 Rd. in Knox

Lot: 10012 1/2 Rd. in Knox  
County: Hamilton  
Phone: 317-843-8413

400' Top of the Lake

Property Description:

This property is being sold for connection to the Fall Creek Regional  
Waste District. The owner has indicated that the property is used for  
residential purposes. The property is located in the Fall Creek Regional  
Waste District.

All connections and materials shall conform to the standards of the  
Fall Creek Regional Waste District. The owner shall be responsible for  
obtaining all necessary permits and approvals from the Fall Creek Regional  
Waste District. The owner shall be responsible for the cost of the  
connection and materials. The owner shall be responsible for the cost of  
the connection and materials. The owner shall be responsible for the cost of  
the connection and materials.

The Fall Creek Regional Waste District is responsible for the inspection,  
approval, and installation of the connection. The owner shall be  
responsible for the cost of the connection and materials. The owner shall  
be responsible for the cost of the connection and materials. The owner shall  
be responsible for the cost of the connection and materials.

The owner shall be responsible for the cost of the connection and materials.

*[Signature]*  
FALL CREEK REGIONAL WASTE DISTRICT

DATE: Sept 14, 1999

BY: *[Signature]*

FOR: *[Signature]*

DATE: Sept 14, 1999

BY: *[Signature]*

FOR: *[Signature]*

## FALL CREEK REGIONAL WASTE DISTRICT

P.O. Box 59 • 9378 S. 650 West • Pendleton, Indiana 46064-0059 • (765) 778-7544

September 9, 1999

8-8443

Ms. Rebecca Gassmann  
RGG Builders

RE: Lot 65 – Hickory Hills East  
Pendleton, IN

Dear Ms. Gassmann:

Please be advised that the connection fee for the above referenced property is \$400.00. This fee is due to Fall Creek at the time you apply for a connection permit.

Let me know if you need further information.

Respectfully,

Teresa Hutton  
Office Manager

R G G BUILDER  
REBECCA GASSMANN  
236 ADAMS STREET PH. 765-778-8443  
PENDLETON, IN 46064

20-7043/2740

1006

DATE Sept 14, 1999

PAY TO THE  
ORDER OF

F. C. R. W. D.

\$ 400.00

Four Hundred - 00/100

DOLLARS  Security features  
included.  
Details on back.



FIRST INDIANA® BANK  
INDIANAPOLIS, INDIANA 46204

MEMO \_\_\_\_\_

Rebecca Gassmann

⑆ 274070439⑆ 170011149⑆ 1006

SAFETY PAPER