

Fall Creek Regional Waste District
9378 S 650 W, P.O. Box 59, Pendleton, IN 46064
765-778-7544

#6478

Agreement for Sanitary Sewer Service

This Agreement made and entered into this 29 day of January, 20 14 between Fall Creek Regional Waste District ("District") and Chad Frank ("Applicant") regarding the provision of sanitary sewer service, and the assignment of capacity in and connection to, the District's facilities for the premises located at Hickory Hills East Lot 78
6038 4032 S Red Box RD

Now therefore, the parties, in consideration of the mutual promises set out in this Agreement, the receipt and sufficiency of which is hereby acknowledged, agree as follows:

1. The Applicant agrees that all workmanship and materials shall conform to all District ordinances and the District's construction standards. District must accept and approve all work and materials before backfilling and final connection is made to the sewer mains. Any violation of this provision will cause all lines and appurtenances in violation to be removed and replaced at the Applicant's expense.
2. The District shall have the right to enter upon the Applicant's premises at all reasonable times to inspect, repair, or replace any equipment used in connection with the District's service or which has an impact on said service.
3. The Applicant shall be responsible for all monthly user rates, capacity charges, and tap fees. The failure to pay any rate charge or fee may result in a lien against the property and/or the termination of service to the property, the cost of which will be borne by Applicant, including, but not limited to, all attorney's fees and collection costs.
4. The District shall not be responsible for any damages as a result of any failure to supply service unless said damages are due to default, neglect or culpability on the part of the District.
5. If there is an available sanitary sewer within three hundred (300) feet of the property line, the property owner shall be required to connect to the District's sanitary sewer system.
6. The Applicant and District agree that the provision of sanitary sewer service touches and concerns the property and the terms of this Agreement bind the District and Applicant and their heirs, executors, administrators, personal representatives, successors, agents, attorneys, assigns, designees, and transferees.

The parties hereto have read and fully understand the above provisions and agree to comply with said provisions.

FALL CREEK REGIONAL WASTE DISTRICT
Rebecca Hunter
Signature

APPLICANT
Chad Frank
Signature

STATE OF INDIANA)
) SS:
COUNTY OF MADISON)

SUBSCRIBED I sworn to before me this 29 day of January, 20 14

My Commission Expires:



Commission Expires November 20, 2015
A Resident of
Hamilton County, Indiana
Rebecca Lynn Hunter, Notary Public

Signature

Rebecca Lynn Hunter

Printed

Rebecca Lynn Hunter

Notary Public

Resident of Hamilton County

Inspector T Date 6/20/14 Approved / Rejected /

Reason for Rejection

Date Reinsp / Approved / Rejected /

Notes:

Size Pipe 6" Type Pipe SDR35

Basement Yes / No /

Sump Pump Yes / No /

Downspout to Ground Yes / No /


Septic Tank Pumped & Filled Yes / No /

Contractor J&R Construction

Special Conditions

Existing Home

New Construction /

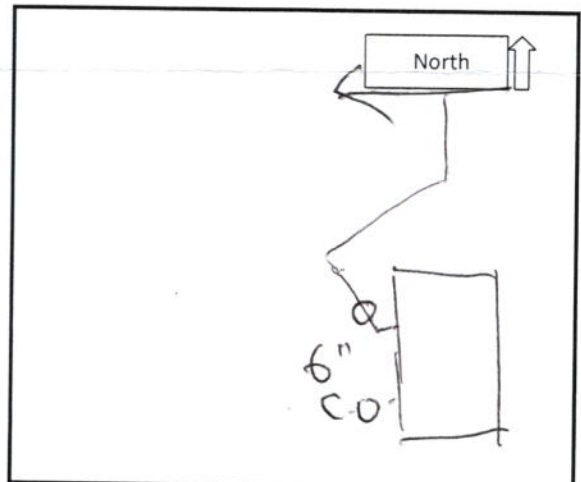

COPY

CHAD FRANK
DIANA P. FRANK
6261 WOODCHUCK DR.
PENDLETON, IN 46064-8616

503

71-208/749

1.29.14
date

Pay to the
Order of

FCRWD

\$ 475.00

Four hundred seventy-five and 00/100 Dollars



Security
Features
Details on
Back



For

Sewage Permit

Diana P. Frank

MP

⑆074902082⑆

0317811050⑈

015

Copy