

**Gidw.**


PROJECT Phase II SHEET \_\_\_\_\_ OF \_\_\_\_\_

SUBJECT \_\_\_\_\_ DATE 5-10-18

JOB NO. 4447

BY Atlas

604 W. State

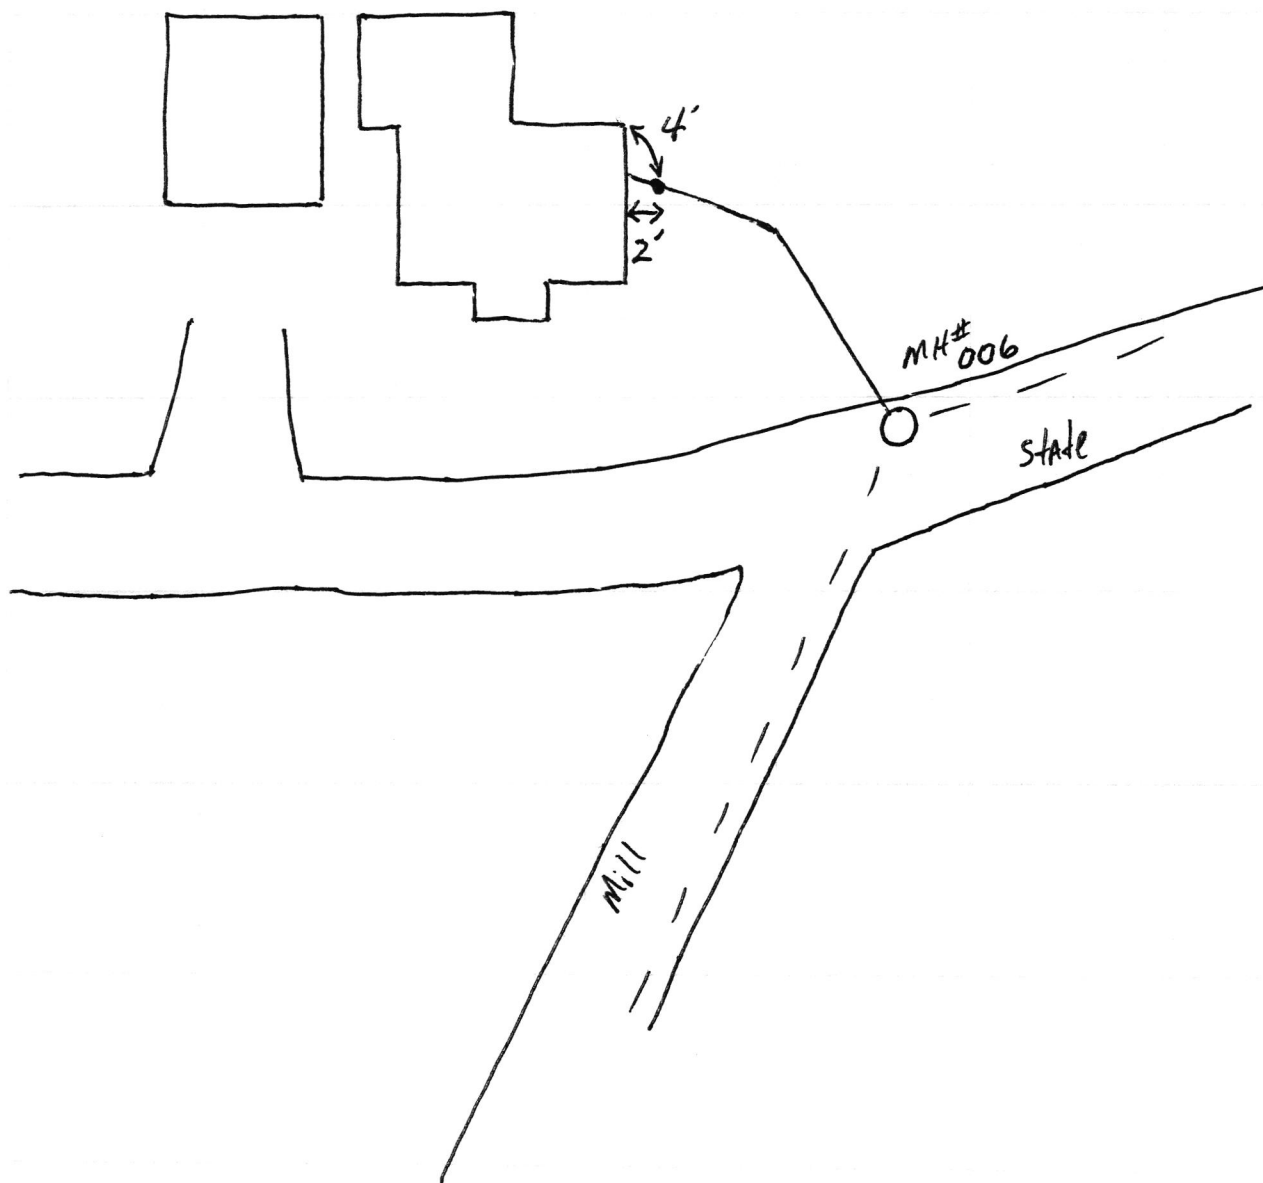



LOW W STATE

SIP Phase II

5.14.18

